Township No. 27 N. Range No. 16 West Mer. (Mich.)

17-12

LAKE MICHIGAN.

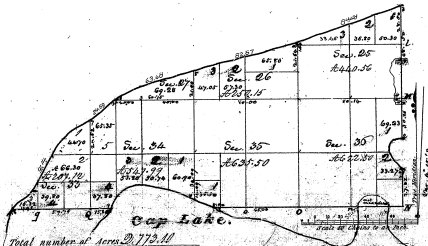

Meanders of Lakes and Navigable Rivers.

Point	Courses	Dist Lks	Point	Courses	Dist Lks	Point	Courses	Dist Lks
Head of an Island in Section 26								
1.	N 35° 00' E	19.00						
	N 74° 00' E	9.50						
2.	N 16° 00' E	9.15						
Head of an Island in Section 25								
10.	N 49° 00' W	10.50						
	N 79° 00' W	20.00						
	S 81° 00' W	33.00						
	S 74° 00' W	13.50						
	S 68° 00' W	9.50						
9.	S 59° 00' W	6.00						
Lakes Meanders								
1.	N 77° 00' E	20.00						
	N 25° 00' E	41.00						
2.	N 64° 00' E	20.00						
3.	N 25° 00' E	38.00						
	N 46° 00' E	20.00						
4.	N 31° 00' E	40.00						
5.	N 25° 00' E	20.00						
6.	N 25° 00' E	20.00						
7.	N 7° 00' E	40.00						

Surveys Designated.	By Whom Surveyed.	Date of Contract.	Total number of Acres 2,772.80 Amount of Surveys	When Surveyed.	When Changed the Sur. Gen'l &c.
Exterior lines of Tp.	A. Ransom	Aug 25th 1838	23 76	0th qr	1839	3rd qr	1839
Tp. Subdivisions	Sidney Rodgers	Jan 21 1839	1. 68. 50		
			9. 15. 07		

The above Plats of Township No. 27 N. of Range No. 16 West of the Principal Meridian Michigan is strictly conformable to the field notes of the survey thereof returned to this Office, and have been examined and approved.

Surveyor Generals Office
Monument Sept. 24th 1839

E. S. Thomas Surv. Genl.