Township N. VI south, Range N. V West Mer. (Mic. Ter.)

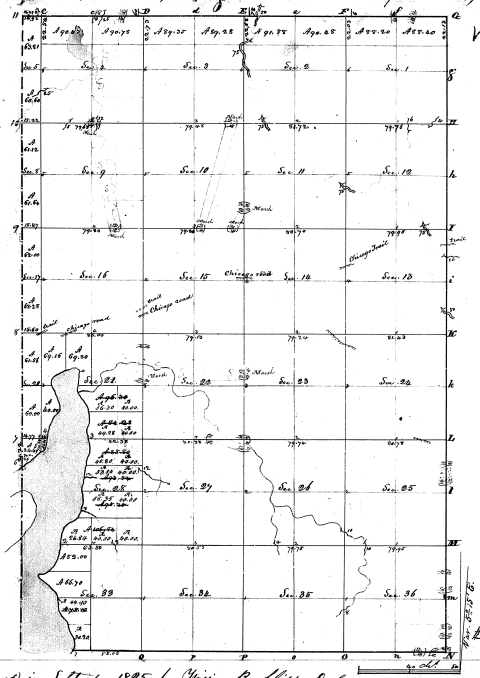

No. of Sec.	Contents Acres.	Contents Wthds.
NE 1	158	30
NW	114	03
SL	320	
NE 2	109	96
NW	111	62
SL	320	
NE 3	111	12
NW	109	52
SL	320	
NE 4	108	64
NW	107	76
SL	320	
NE 5	107	93
NW	107	80
SL	320	
NE 6	107	52
NW	66	90
SE	160	
SW	65	62
EL 7	320	
NW	47	—
SW	240	64
Sec. 8	640	
9	640	
10	640	
11	640	
12	640	
13	640	
14	640	
15	640	
16	640	
17	640	
EL 18	329	
NW	97	36
SW	97	54
EL 19	324	
NW	98	84
SW	97	28
Sec. 20	640	
21	640	
22	640	
23	640	
24	640	
25	640	
26	640	
27	640	
28	640	
29	640	
EL 30	320	
NW	93	68
SW	98	00
NL NE 1	98	60
SL	50	
NL NW	98	20
SL	50	
	320	
NL NE 2	90	25
SL	50	
NL NW	91	88
SL	50	
	320	
NL NE 3	89	28
SL	50	
NL NW	89	35
SL	50	
SL	320	
	1977	59

No. of Sec.	Contents Acres.	Contents Wthds.
EL 31	320	
NW	102	60
SW	110	56
Sec. 32	640	
33	640	
34	640	
35	640	
36	640	
NL NE 4	90	78
SL	50	
NL NW	90	43
SL	50	
	320	
fr. NL 5	63	81
fr. SL	60	60
fr. NE 8	61	12
fr. SE	81	64
Sec. 9	640	
10	640	
11	640	
12	640	
fr. NL 17	52	
fr. SL	67	28
fr. NL 20	61	58
fr. SL	60	
NE 21	160	
EL NW	83	80
NL	83	16
SL SE	86	20
NL	96	30
fr. SW	40	—
SE	640	
23	640	
24	640	
25	640	
26	640	
27	640	
NL NE 28	95	80
SL	93	52
NL SE	93	35
SL	100	52
NW fr.	41	88
NE 29	96	49
EL 33	320	
NL NW	82	
SL	66	70
SW	73	10
Sec. 30	602	
35	640	
36	640	
	13,423	24
	1977	59
Total	15,455	83

(3) 41-4

Township No. VI south, Range No. V west Mer. (Mic. Ter.)

4-14

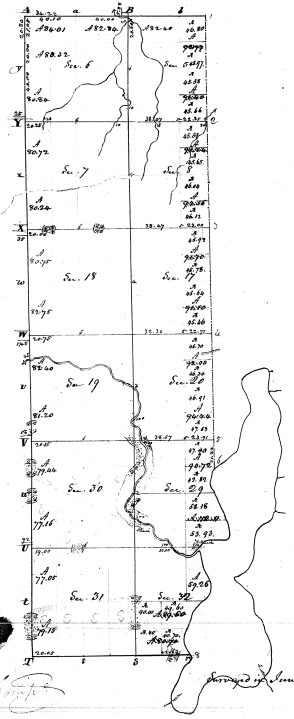
Sec. 6
Sec. 7
Sec. 18
Sec. 19
Sec. 30
Sec. 31
Sec. 32
Meander
Meander
Meander