Township N. VI South, Range N. XVI West (Mic. Prin.)

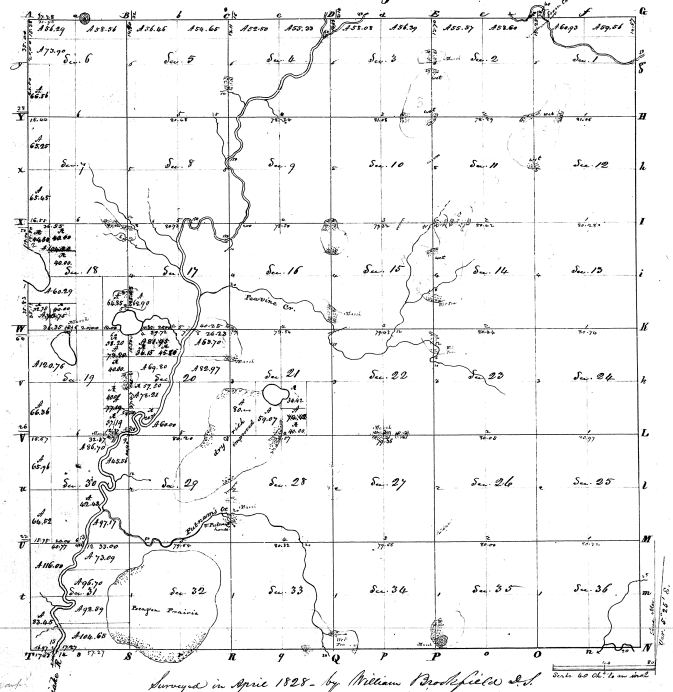

1-21

Surveyed Portions			Reserved Portions		
Sections	Acres	Hds.	Sections	Acres	Hds.
NL NE 1	59	51	SL NE 19	79	20
SL "	80		NL "	80	
NL NW "	60	93	" NW "	124	71
SL "	80		SL SE "	77	19
" SW "	320		NL "	80	
NL NE 2	58	60	SL SW "	80	
SL "	80		NL "	66	36
NL NW "	58	57	NL NE 20	63	70
SL "	80		SL "	92	72
" SW "	320		NL NW "	81	98
NL NE 3	58	59	SL "	69	80
SL "	80		SL SE "	160	
NL NW "	58	08	Sf. SW "	60	00
SL "	80		Wf. "	79	21
" SW "	320		NL NE 21	320	
NL NE 4	55	33	SL SE "	80	
SL "	80		NL "	74	42
NL NW "	52	50	SL SW "	69	07
SL "	80		NL "	80	
" SW "	320		Sec. 22	640	
NL NE 5	54	65	23	640	
SL "	80		24	640	
NL NW "	56	46	25	640	
SL "	80		26	640	
" SW "	320		27	640	
NL NE 6	58	56	28	640	
SL "	80		29	640	
NL NW "	58	29	Sf. NE 30	45	56
SL "	73	90	Wf. "	84	70
SE "	160		SL NW "	80	
SL SW "	80		NL "	65	96
NL "	66	56	Sf. SE "	57	17
SE NW "	320		Wf. "	62	48
SL NW "	80		SL SW "	80	
NL "	65	25	NL "	64	52
SL SW "	80		Alone NE 31	73	09
NL "	63	65	S Part "	94	16
Sec. 31	640		Alone SE "	93	89
9	640		S Part "	104	65
10	640		Wf. NW "	116	00
11	640		Wf. SW "	83	45
12	640		Sec. 32	640	
13	640		33	640	
14	640		34	640	
15	640		35	640	
16	640		36	640	
SL 17	192			7855	38
NW "	160			10 155	07
SL SW "	80			2,493	55
NL "	68	90			
" NE 18	160				
NW "	104	20			
SL SE "	64	85			
NL "	80				
NL SW "	60	29			
SL "	72	55			
	7078	07			

1-21