Township N.° VII South, Range N.° XV West (Mic. Ter.)

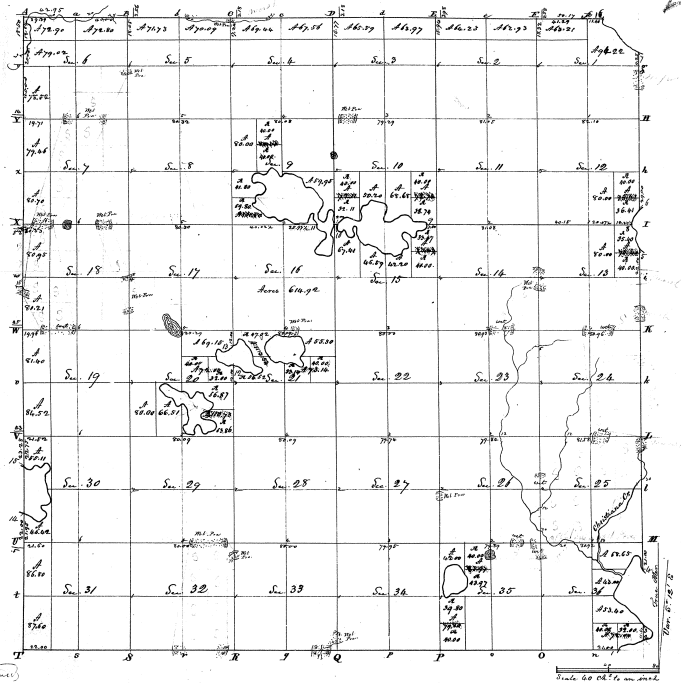

Surveyed in June 1828 – by William Brookfield D.S.

Contents			Contents		
Sections	Acres	Hds	Section	Acres	Hds
fr. NE 1	92	22	E.L 18	320	
N.L NW "	63	21	E.L NW "	80	
S.L " "	80		N.L " "	80	95
S½ "	320		E.L SW "	80	
N.L NE 2	62	93	W.L " "	80	21
S.L " "	80		E½ 19	320	
N.L NW "	64	23	E.L NW "	80	
S.L " "	80		W.L " "	81	40
S½ "	320		E.L SW "	80	
N.L NE 3	63	97	W.L " "	84	52
S.L " "	80		N.L NE 20	69	15
N.L NW "	65	59	S.L " "	72	00
S.L " "	80		NW "	160	
S½ "	320		fr. SE "	110	73
N.L NE 4	67	56	E.L SW "	66	51
S.L " "	80		W.L " "	80	
N.L NW "	69	44	N.L NE 21	55	30
S.L " "	80		S.L " "	73	14
S½ "	320		fr. NW "	103	54
N.L NE 5	70	09	S½ "	320	
S.L " "	80		Sec. 22	640	
N.L NW "	71	73	23	640	
S.L " "	80		24	640	
S½ "	320		25	640	
N.L NE 6	72	80	26	640	
S.L " "	80		27	640	
N.L NW "	72	90	28	640	
S.L " "	79	02	29	640	
SE "	160		E½ 30	320	
E.L SW "	80		E.L NW "	80	
W.L " "	78	52	W.L " "	55	11
E½ 7	320		E.L SW "	80	
E.L NW "	80		W.L " "	46	42
W.L " "	79	46	E½ 31	320	
E.L SW "	80		E.L NW "	80	
W.L " "	80	70	W.L " "	86	80
Sec. 8	640		E.L SW "	80	
N½ 9	320		W.L " "	87	60
N.E.fr. SE "	59	95	Sec. 32	640	
W.fr. S½ "	101	60	33	640	
N½ 10	320		34	640	
E.L SE "	78	74	E½ 35	320	
W.L " "	68	68	E.L NW "	83	97
E.L SW "	50	20	W.L " "	42	
W.L " "	72	11	E.L SW "	80	
Sec. 11	640		W.L " "	79	80
W½ 12	320		W½ 36	320	
NE "	160		N.L NE "	68	65
E.L SE "	76	61	S.L " "	63	00
W.L " "	80		N.L SE "	53	40
E.L NE 13	75	40	S.L " "	72	00
W.L " "	80			11836	20
NW "	160			10344	05
S½ "	320			22180	25
Sec. 14	640				
S½ 15	320				
E.L NE "	73	47			
W.L " "	42	20			
E.L NW "	46	59			
W.L " "	67	41			
fr. Sec. 16	614	92			
Sec. 17	640				
	10344	05			