Township N.° 38 N. Range N.° 10 W. Mer. Mich.

Big Beaver Island.

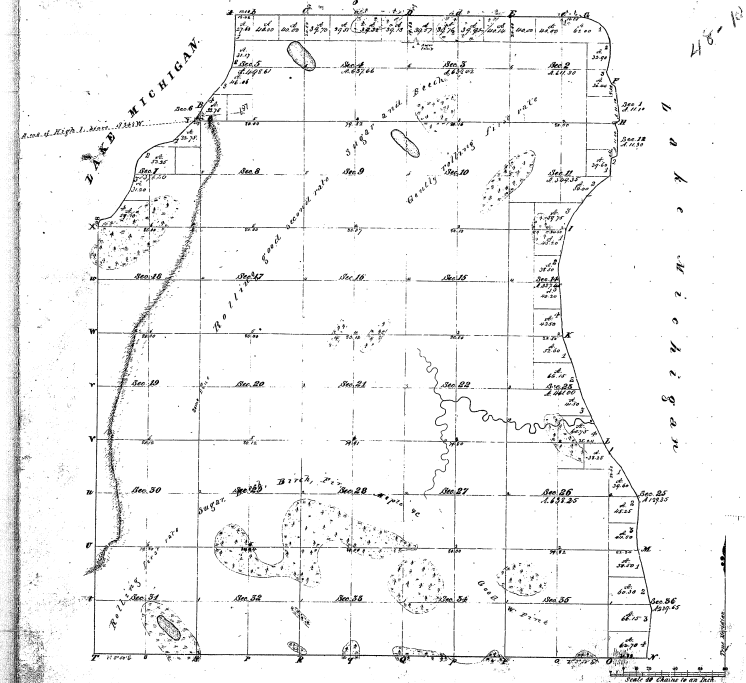

Total number of Acres 17932.24

Surveys Designated.	By Whom Surveyed.	Date of Contract.	Amount of Surveying. M.	Ch.	Lks.	When Surveyed.	When Changed to the Surveyed out.
Township Lines.							
Subdivisions.	John Couch	July 24 1843	55	00	00	Sept 1845	

The above Map of Township N.° 38 North, of Range N.° 10 West of the [illegible] is hereby approved, and the Surveys therein represented, are conformable to the laws of the United States.

Surveyor General's Office, Detroit 27 January 1846

Lucius Lyon, Surveyor General

Standing at
Post | Courses | Dist Lks | Posts | Courses | Dist Lks | Posts | Courses | Dist Lks

48-10

48-10