# Township N° 38 N. Range N° 11 W. Mer. Mich.

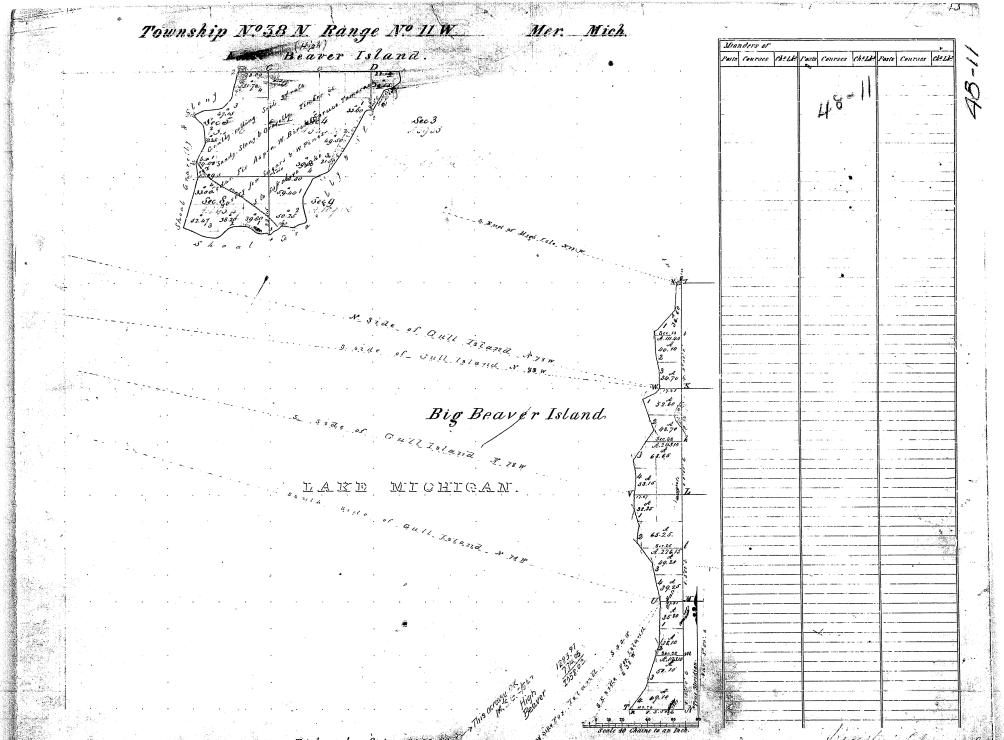


Total number of Acres 2338.67

| Surveys Designated. | By Whom Surveyed. | Date of Contract. | Amount of Surveys. M. | Ch's | Lks | When Surveyed. | When Entered in the Book of Plats. |
|---|---|---|---|---|---|---|---|
| Township Lines | Jas. Dunn Deputy | | | | | | |
| Subdivisions | Jas. Dunn Deputy | April 26th 1848 | 5 | 52 | 67 | Aug 9th 1848 | |
| | of Said Township | June 1 1849 | 8 | 20 | 79 | Sept 1849 | |
| | Millecan Dep. | | | | | | |

The above Map of Township N° 38 North of Range N° 11 West of the Principal Meridian, Michigan is strictly conformable to the field notes of the survey thereof on file in this Office, which have been examined and approved.

Surveyor Generals Office
Detroit Oct 29 1850

Lucius Lyon Surv Gen'l