Resurvey

Township No. 39 N. Range No. 3 W. Mer. Mich.

19-4

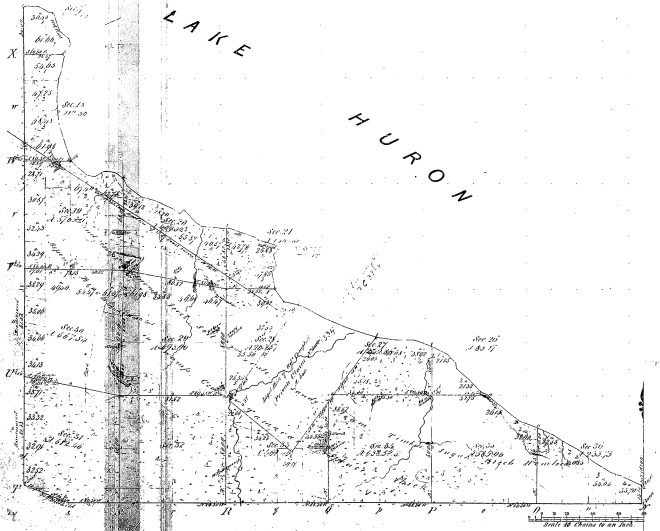

Meandering of

Posts	Courses	Ch. Lk.	Posts	Courses	Ch. Lk.	Posts	Courses	Ch. Lk.

Meander Posts 61 Cor. 63 Lat.

Note. Note shaded yellow sold prior to the resurvey

Total number of Acres 655.45

Surveys Designated.	By Whom Surveyed.	Date of Contract.	Amount of Surveys. M. Ch. Lk.	When Surveyed.	When Charged in the Surv. Gen'l's acct.
Township lines.	[illegible]	April 12th 1840	5 . 13 . 10	3rd Quar. 1840	
S.W. and N.E. [illegible]	[illegible]	April 6th 1840	76 . 90	2nd Quar. 1840	
Subdivisions.	[illegible]	April 6th 1840	73 . 15 . 01	2nd Quar. 1840	
Meandering of Lines on the Lake [illegible]	[illegible]			2nd Quar. 1840	

The above Map of Township No. 39 North of Range No. 3 West of the Principal Meridian of Michigan is strictly conformable to the field notes of the survey thereof on file in this Office and have been examined and approved.

Surveyor General's Office
Detroit, Sept. 20th 1837

Saunders Chapman Sur. Genl.

Comd. Copy made