Township № 43 N. Range № 1 E. Mer. (Mich.)

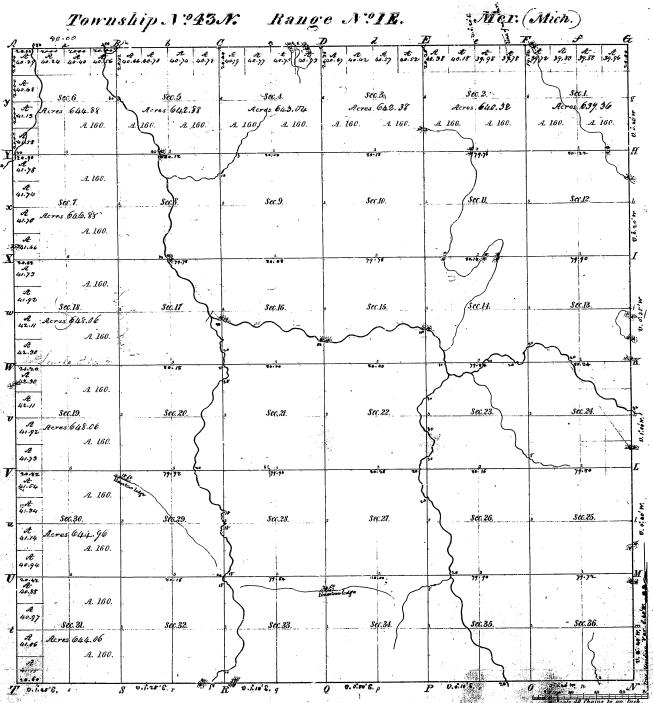

Meanders of

South Courses	West	East Courses	West	South Courses	West

33-19

33-19

Total number of Acres 23 014.88

Surveys Designated	By Whom Surveyed	Date of Contract	Amount of Surveys	When Surveyed	When plat was made and by the Surveyor Gen'l.
Township lines	Wm. A. Burt	June 15th 1840	M. Chs. Lks.	1840	
Subdivisions	John Mullett	June 9th 1845	60 05 33	1845	

The above Map of Township № 43 N. of Range № 1 East of the Principal Meridian Michigan is strictly conformable to the field notes of the survey thereof on file in this Office which have been examined and approved.

Surveyor General's Office
Detroit July 26 1845

Lucius Lyon, Surv. Gen'l.