Township No. 43 N. Range No. 6 E. Mer. Mich.

Drummond's Island.

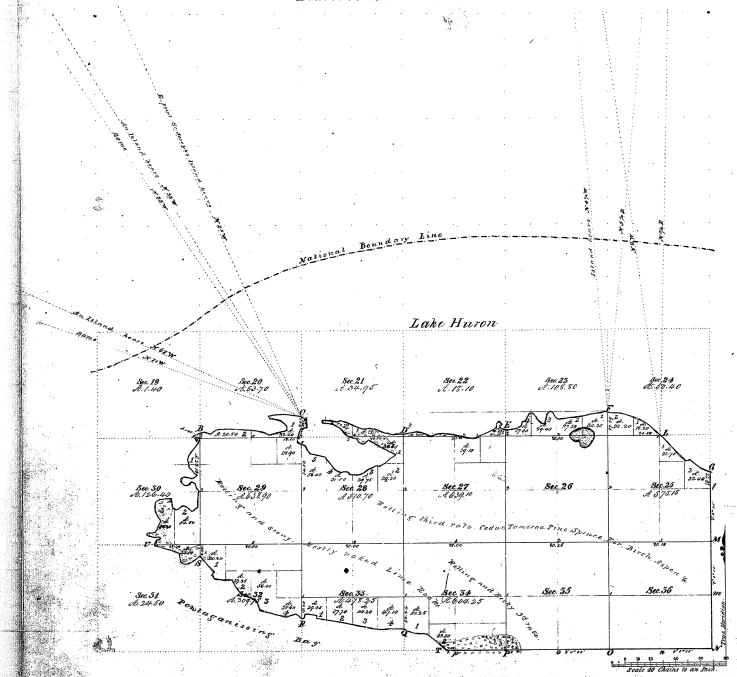

Meanders of								
Town	Course	Dist. Lks.	Town	Course	Dist. Lks.	Town	Course	Dist. Lks.
33-14								

33-14

Total number of Acres 6494.35

Survey Designated.	By Whom Surveyed.	Date of Contract.	Amount of Surveys. M. Ch. Lks.	When Surveyed.	When Changed in the Out Lines not.
Township lines	Philip Sheridan	April 5th 1848		Oct. of 1848	
Subdivisions	Wm. Mullett		22 23 92		

The above Map of Township No. 43 North of Range No. 6 East of the Principal Meridian, is strictly conformable to the field notes of the survey thereof on file in this Office, which have been examined and approved.

Surveyor Generals Office
Detroit Jany. 8th 1849

Lucius Lyon Surv. Genl.

Reg. Copy

DUPLICATE ORIGINAL

33-14

TOWNSHIP 43 NORTH, RANGE 6 EAST, OF THE MICHIGAN MERIDIAN, MICHIGAN.

SURVEY OF ISLANDS

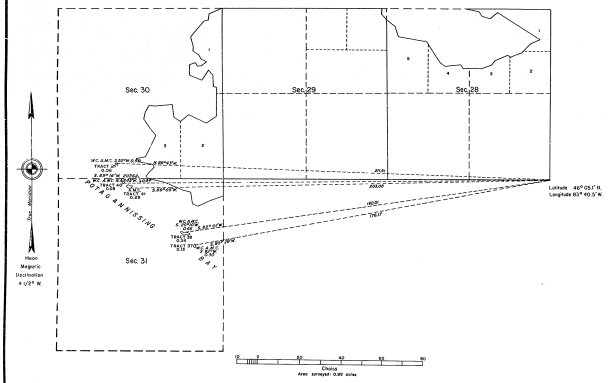

A history of surveys is contained in the field notes.

This plat represents the survey of five islands in Potagannissing Bay, T. 43 N., R. 6 E., Michigan Meridian, Michigan.

Except as indicated hereon, the lottings and areas are as shown on the plat approved January 31, 1846.

Survey executed by Gary L. Kratz, Cadastral Surveyor, beginning October 18, 1977, and completed May 19, 1978, pursuant to Special Instructions dated June 3, 1977, for Group No. 78, Michigan.

UNITED STATES DEPARTMENT OF THE INTERIOR
BUREAU OF LAND MANAGEMENT
Denver, Colorado November 19, 1981

This plat is strictly conformable to the approved field notes, and the survey, having been correctly executed in accordance with the requirements of law and the regulations of this Bureau, is hereby accepted.

For the Director

Acting Chief, Cadastral Survey
Examination and Approval Staff