


## TOWNSHIP NO.45 NORTH, RANGE NO.5 WEST, MICHIGAN MERIDIAN, MICHIGAN

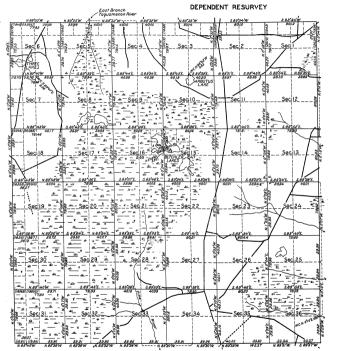

34-23

MEMORANDUM

NOT THE REAT OF THE RESIDUEY OF TOWNSHIP AS NOTHIN ARMOR SEST, DELINEATE ARE REPRACEMENT AND RESTAULABLEST OF THE LINES OF THE ORIGINAL OR

THIS PLAT ALSO REPRESENTS THE SURVEY OF TWO ISLANDS IN A MEANDERED LAKE WITHIN THE TOWNSHIP, WHICH WERE NOT INCLUDED IN THE ORIGINAL SURVEY AS SHOWN UPON THE OFFICIAL PLAT.

SHOWN UPON THE OFFICIAL PLAT.
AUTHORITY FOR THE RESUNCY OF THE TOWNSHIP
IS CONTAINED IS GENERAL LAND CFFICE LETTER.
HQB660, "E" OATED MARCH, 1, 1931, WHICH BEARS DEPARTMENTAL APPROVAL UNDER DATE OF MARCH 5, 1931,
THE ISLAMO SURVEYS WERE AUTHORIZED BY LETTER DATE
SEPTEMBER 10, 1932, WHICH BEARS DEPARTMENTAL APPROVAL WINDER THE SAME DATE.

THE TOWNSHIP HAS EXTENSIVE AREAS OF OPEN MUS-KEG MARSH, AND SPRUCE, TAWARACK AND CEDAR SWAMPS. THE UPLAND HAS A SCATTERING GROWTH OF SMALL TIM-BER CONSISTING MAINLY OF JACK PINE AND POPLAR.

OFFICE OF U. S. SUPERVISOR OF SURVEYS,
DONNER, DOLORADO, JULY I, 1935
THE ABOVE PLAT OF TOWNSHIP NO. 15, 1907FM,
RANGE NO. 5 WEST OF THE MICHIGAN MERICIAN, IN THE
STATE OF MICHIGAN, IS STATELY CONFORMALE TO THE
FIELD MOTES OF THE RESURVEY THEREOF, WHICH HAVE
BEEN EXAMINED AND APPROVED.

Manuell Dimeon
U. S. SUPERVISOR OF SURVEYS.

DEPARTMENT OF THE INTERIOR.
GENERAL LAND OFFICE.
WASHINGTON, D. C., FEGRUARY 27, 1936.
THE SURVEY REPRESENTED BY THIS PLAT, HAVING
BEEN CORRECTLY EXCURED IN ACCORDANCE WITH THE
REQUIREKING OF LAW AND THE REQUIREKING OF THIS
OFFICE, IS HERBY ACCOPTED.

Controlle Tomes P., ASSISTANT COMMISSIONER.

SCALE: 40 CHAINS TO AN INCH.

AREA RESURVEYED: 22,867.63 ACRES.
AREA SURVEYED: 5.12 ACRES.

- 1.	LINES DESIGNATED	BY WHOM SURVEYED	GROUP		MILEAGE		WHEN SURVEYED	
Ľ			NO.	DATE	MLS.	CHS.	BEGUN	COMPLETED
	EXTERIOR SUBDIVISIONAL MEANDERS CONNECTIONS	GUY R. VEAL; U. S. CADASTRAL ENGINEER.	31	JUNE 8, 1932. SEPT. 1, 1932.	23 59 2	74.97 65.54 34.82 4.00	JULY 29, 1932.	1932.