Township N.º 50 N. Range N.º 7 W. Mer. Mich.

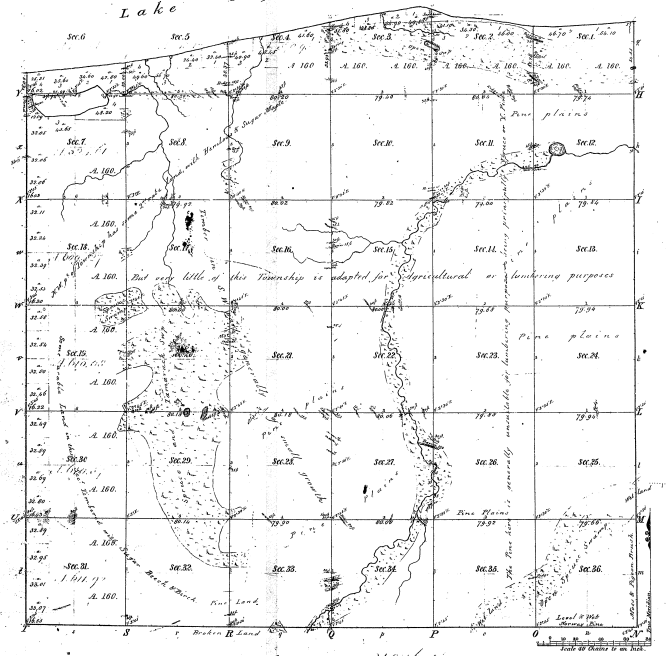

Meanders of

Prob. Courses	Dist.	Prob. Courses	Dist.	Prob. Courses	Dist.	Prob. Courses	Dist.

Total number of Acres. 10715.56

Surveys Designated	By Whom Surveyed	Date of Contract	Amount of Surveys	When Surveyed	When approved and sent to the Surveyor Gen.l's Office
Township lines	Wm A. Burt	June 11th 1840	M. Ch. Lks.	1st Qr. 1840	
Subdivisions	Wells Burt	June 29th 1840	66. 10. 47.	4th Qr. 1840	

The above Map of Township N.º 50 North of Range N.º 7 West of the Principal Meridian Michigan, is strictly conformable to the field notes of the survey thereof on file in this Office, which have been examined and approved.

Surveyor Generals Office, Detroit Mich. 1st 1850

Charles Noble Surv.r Gen.l