Resurvey

Township No. 19 N Range No. 6 W. Mer. Mich.

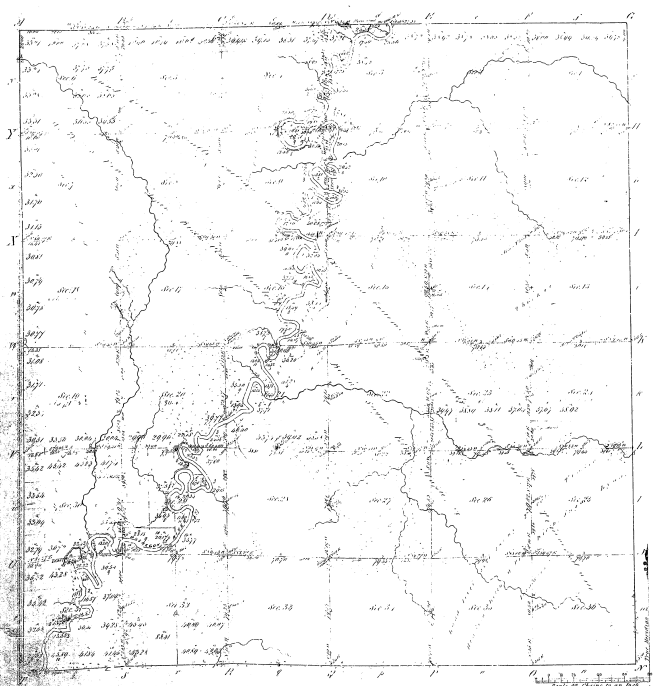

Total number of Acres 22 & 67 56.

Surveys Designated	By Whom Surveyed	Date of Contract	Amount of Surveys M. Ch. Lks.	When Surveyed	When Charged in the Surv. Genl. Acct.
Township lines N.B.	H. H. Wheeler		5 79 00	2nd Quar. 1833	
" "	F. B. Nicholson	July 21st 1833	6 00 00	1st Quar. 1839	
Subdivisions	F. Chapman	March 24th 1830	75 86 08	1st & 2nd Quar. 1836	
Township 19 N	F. Chapman	Nov. 1st 1830			

The above Map of Township No. 19 N. Range No. 6 W. Mer. of the Principal Meridian of Michigan is strictly conformable to the field notes of the survey thereof on file in this Office, which have been examined and approved.

Surveyor General's Office,
St. Louis, Mo. 1837

C. L. Wheeler Sur. Genl.

12-6