Township N.° VIII North, Range N.° III West Mer. (Mic. For.)

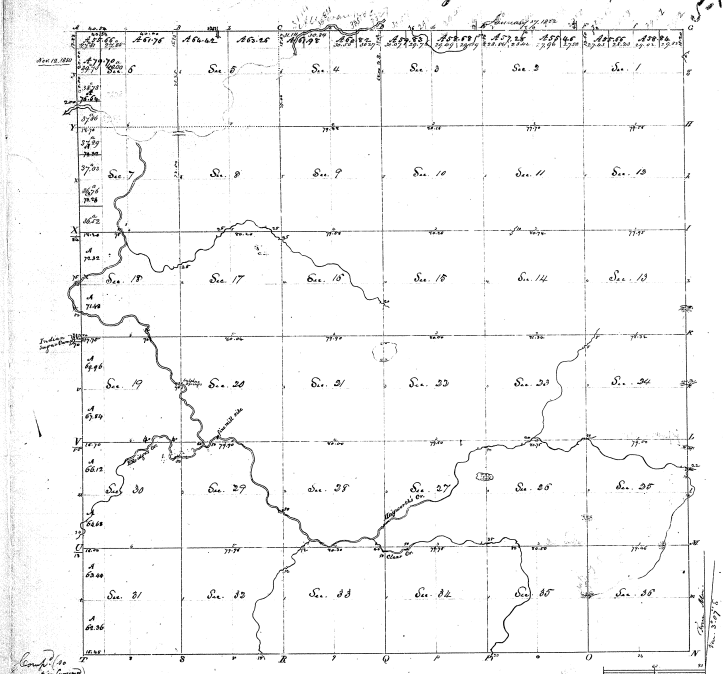

Surveys in April & May, 1831 by Joel Wright, D. S.

The above Maps of Township N.° 8 N., Range N.° 3 W. Mer. (Miss. Ter.) is truely conformable to the field notes of the Survey thereof on file in this Office, which have been examined & approved.

Surveyor General's Office, Cincinnati, Dec.r 6.th 1831

M. T. Williams Surv.r Gen.l

Sections			Contents Acres	Hds
N½	NE	1	58	26
S½			80	
N½	NW		58	58
S½			80	
			320	
N½	NE	2	58	46
S½			80	
N½	NW		57	28
S½			80	
			320	
N½	NE	3	58	68
S½			80	
N½	NW		59	83
S½			80	
			320	
N½	NE	4	60	82
S½			80	
N½	NW		61	95
S½			80	
			320	
N½	NE	5	63	26
S½			80	
N½	NW		64	42
S½			80	
			320	
N½	NE	6	61	76
S½			80	
N½	NW		55	66
S½			77	70
			320	
E½	SW		80	
W½			76	64
	S½	7	320	
E½	NW		80	
W½			74	32
S½	SW		80	
W½			73	28
	Sec.	8	640	
		9	640	
		10	640	
		11	640	
		12	640	
		13	640	
		14	640	
		15	640	
		16	640	
		17	640	
	S½	18	320	
E½	NW		80	
W½			72	32
S½	SW		80	
W½			71	48
			11481	29

Sections			Contents Acres	Hds
	S½	19	320	
E½	NW		80	
W½			63	96
E½	SW		80	
W½			67	84
	Sec.	20	640	
		21	640	
		22	640	
		23	640	
		24	640	
		25	640	
		26	640	
		27	640	
		28	640	
		29	640	
	S½	30	320	
E½	NW		80	
W½			66	12
E½	SW		80	
W½			64	68
	S½	31	320	
E½	NW		80	
W½			63	44
E½	SW		80	
W½			62	36
	Sec.	32	640	
		33	640	
		34	640	
		35	640	
		36	640	
			11454	40
			11401	29
			22855	69