Reserve

Township No. 28 N. Range No. 1 W. Mer. Mich.

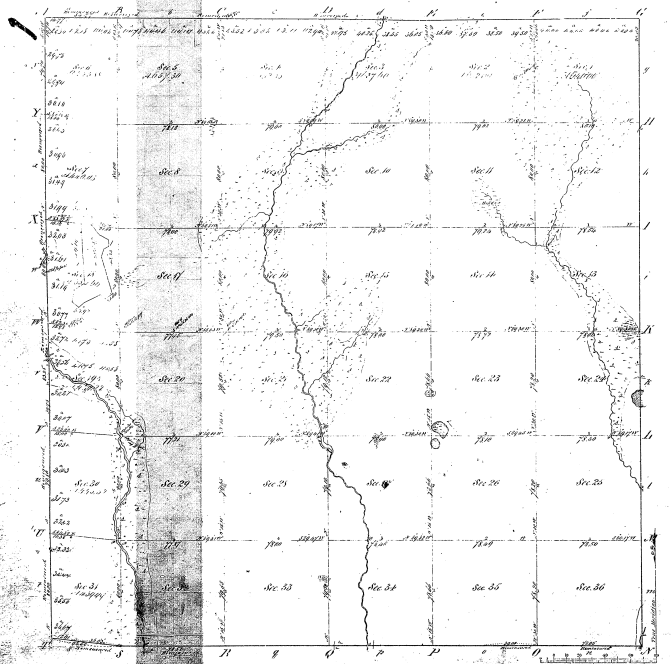

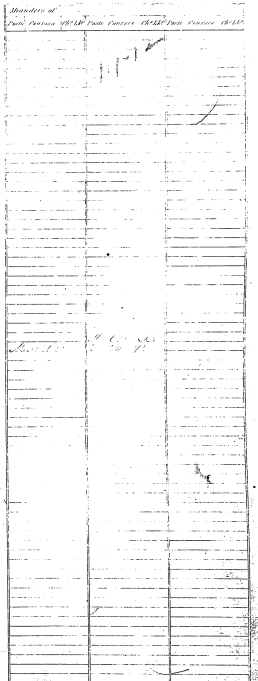

Survey Projected	When Commenced	Returned	Amount of Survey in Chs.	When Surveyed	When Accepted	Total number of Acres 21,040.44
Township lines	3 M. March 1839	1839	18 - 52 - 11	3 June 1839		
Subdivisions	Nothing Done	1839	18 - 52 - 11	4 June 1839		

The above Map of Township No. 28 North of Range 01 West of the Principal Meridian of Michigan is strictly conformable to the field notes of the Survey returned and filed in this Office, which have been examined and approved.

Surveyor General's Office Detroit 4 June 1839

Surveyor General

14-12