46-22

Township No. 39 N Range No. 21 W. Mer. Mich

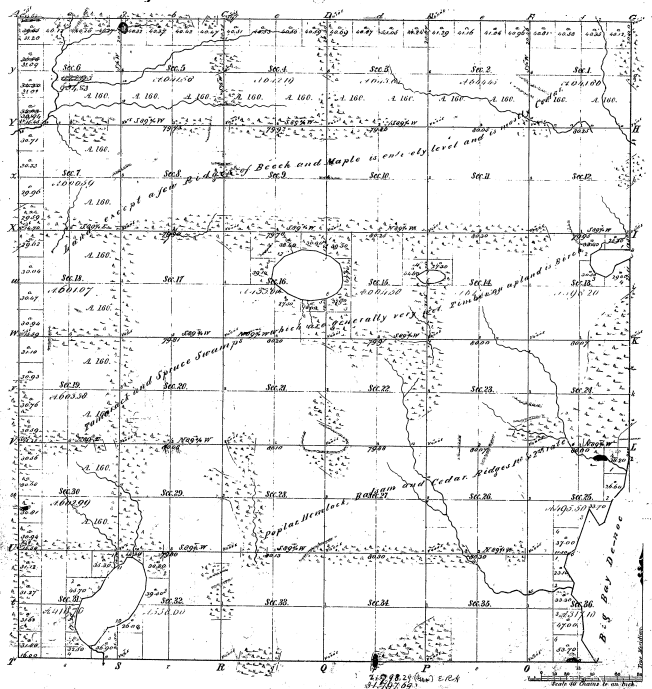

Meanders of

Posts	Courses	Ch. Lk.	Posts	Courses	Ch. Lk.	Posts	Courses	Ch. Lk.

46-22

Total meanders 7 2d 20

Total number of Acres ~~37,415.81~~ 37,367.04

Surveys Designated	By Whom Surveyed	Date of Contract	Amount of Surveys	When Surveyed	When & for and at what Sec. Sec. Tp.	
Township lines	John Burt	26 Jul 1842	4 Ch. 00 Lks.	2nd qr. 1842		
Subdivisions	A Morgan	22 " 1842	36 " 00 "	2nd qr. 1842		
Meanders			8 " 20			

The above Map of Township No. 39 North of Range No. 21 West of the Principal Meridian Michigan, is strictly conformable to the field notes of the survey thereof, on file in this Office, which have been examined and approved.

Surveyor General's Office
Detroit, August 1842

Lucius Lyon
Surv. Genl.