46-11

Township No. 40 N. Range No. 21 W. Mer. Mich.

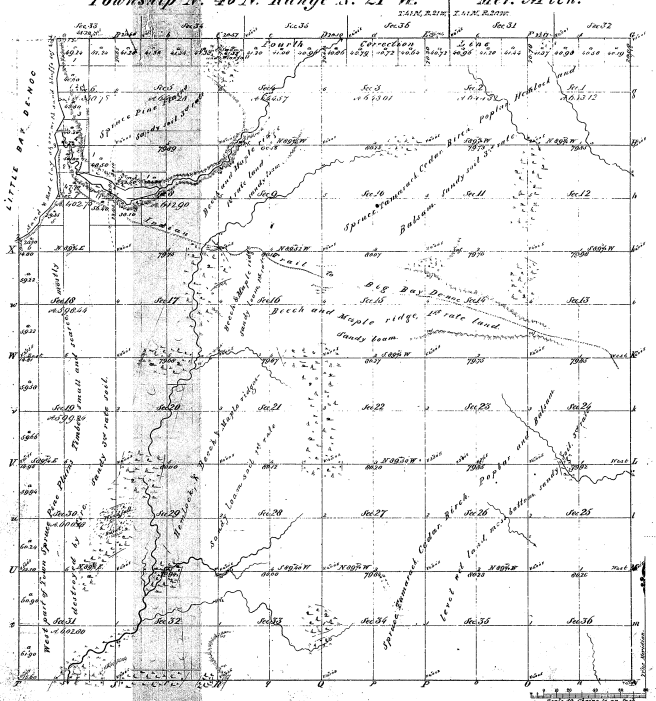

Meanders of									
Posts	Courses	Ch't Lk	Posts	Courses	Ch't Lk	Posts	Courses	Ch't Lk
Total Meanders 3 mi. 68 ch. 22 lks.								

46-11

Total number of Acres 22,347.39

Surveys Designated.	By Whom Surveyed	Date of Contract.	Amount of Surveys. M. Ch't Lk	When Surveyed.	When Charged in the Surv. Genl. acc.
Township Lines.	John Bissell	Feb. 6 1845	11 75 60	3d qr. 1845	
Subdivisions.	A. Hurgrand	February 23 1848	59 26 54	1 & 2 qr. 1848	
Remarks.			3 68 22		

The above Map of Township No. 40 North of Range No. 21 West Principal Meridian Michigan is strictly conformable to the field notes of the survey thereof on file in this Office which have been examined and approved.

Surveyor General's Office
Detroit Sept. 2 1848 — Lucius Lyon, Surv. Genl.

Repts. Copy made