46-8

Township No. 40 N. Range No. 24 W. Mer. Mich.

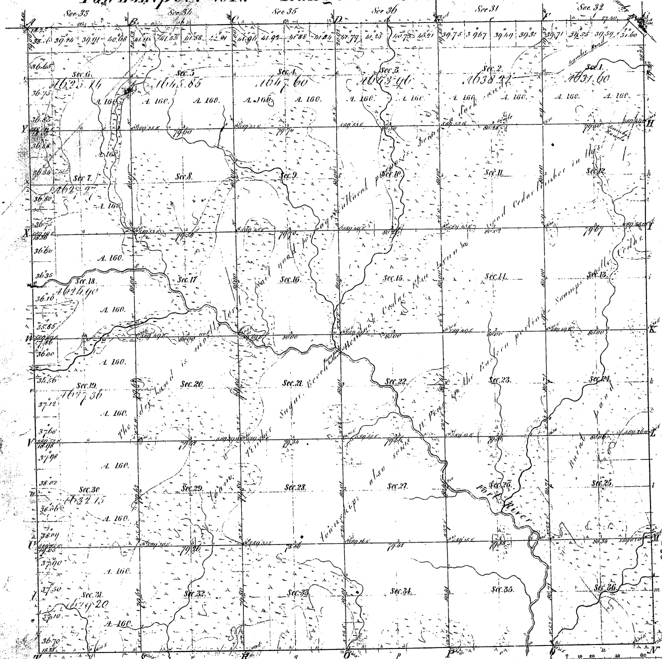

Meanders of								
Posts	Courses	Ch. Lk.	Posts	Courses	Ch. Lk.	Posts	Courses	Ch. Lk.
46 8								
				230 ch. 12 links				

Total number of Acres. 22973.25

Surveys Designated	By Whom Surveyed	Date of Contract	Amount of Surveys	When Surveyed	When pd. for and chd. in the Sur. Genl's acct.
			M. Chs. Lks.		
Township lines	John Mullett	June 26 1847	5 78 25	2nd Quar. 1848	
Subdivisions	Harvey Mellen	Bond Sept. 20 1852	60 14 52	2nd Quar. 1852	
East Boundary	John Burt	Feby. 26 1845	5 79 20	2nd Quar. 1845	

The above Map of Township No. 40 North of Range No. 24 West of the Principal Meridian Michigan is strictly conformable to the field notes of the survey thereof on file in this Office, which have been examined and approved.

Surveyor General's Office
Detroit Dec 17 1852

Charles Noble
Sur. Genl.