46-30

# Township No. 39 N. Range No. 29 W. Mer. Mich.

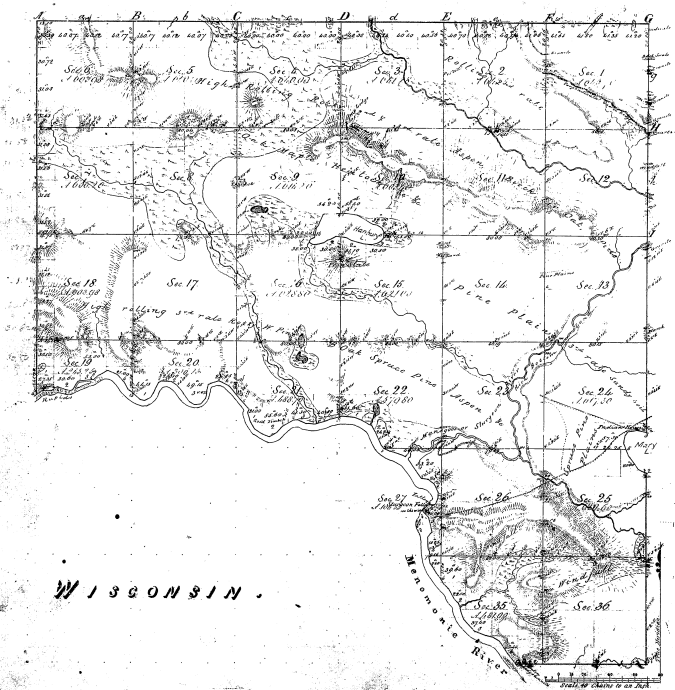


| Meanders of | | | | | | | | |
|---|---|---|---|---|---|---|---|---|
| Posts | Courses | Ch's Lk's | Posts | Courses | Ch's Lk's | Posts | Courses | Ch's Lk's |
| | | | | | | | | |

46-30

Meanders 9 mi. 49 ch. 12 lks

Total number of Acres 16,706.80

| Surveys Designated. | By Whom Surveyed. | Date of Contract. | Amount of Surveys M. | Ch's | Lk's | When Surveyed. | When Charged in the Surv. Genl. Acct. |
|---|---|---|---|---|---|---|---|
| Township lines. | John Mullett | June 24 1847 | 6 | 70 | 36 | 3rd Chain 1845 | |
| Subdivisions. | James H. Mullett | June 27 1849 | 52 | 78 | 39 | 4th Qtr. 1849 | |

The above Map of Township No. 39 North of Range No. 29 West of the Principal Meridian Michigan is strictly conformable to the field notes of the survey thereof on file in this Office, which have been examined and approved.

Surveyor General's Office
Detroit April 1st 1850

Charles Hobbs Surv. Genl.