Township No. 41 N. Range No. 28 Mer. Mich.

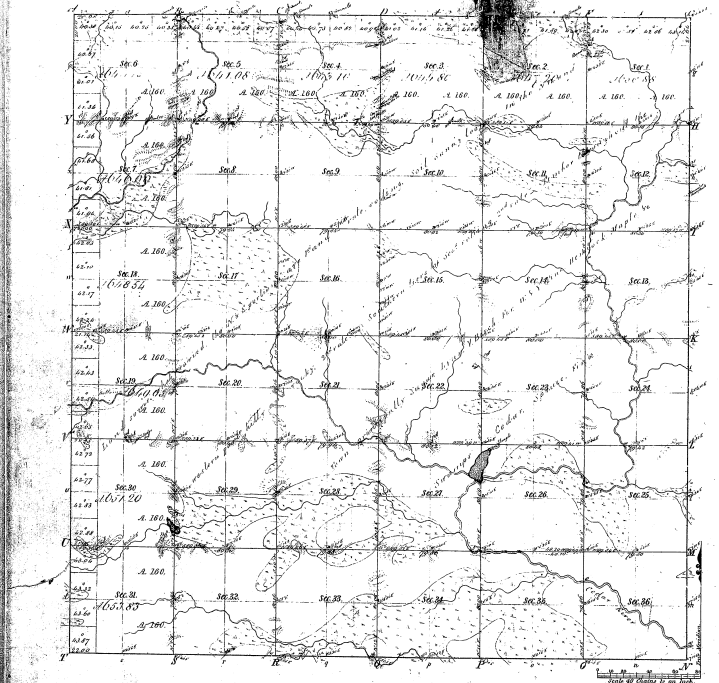

Meanders of								
Posts	Courses	Ch. Lk.	Posts	Courses	Ch. Lk.	Posts	Courses	Ch. Lk.
40-37								

45-37

Total number of Acres 2312 62

Surveys Designated	By Whom Surveyed	Date of Contract	Amount of Surveys	When Surveyed	When pd. for and ch.d in the Surv. Gen.l's acc.t
Township lines	W.L. Lockwood & Bush	Sept. 7 1847	1st 05 / 2nd 03 / 4th 44	2nd Quar. 1846	
Subdivisions	[illegible]		[illegible]	[illegible]	

The above Map of Township No. 41 North of Range No. 28 West of the Principal Meridian Michigan is strictly conformable to the field notes of the survey thereof as filed in this Office which have been approved by the Surveyor General's Office.

Surveyor General's Office
Detroit Mich. 4 [illegible]

Charles Bell
Surv. Genl.