Township. No 38 N Range No 4 W Mer.

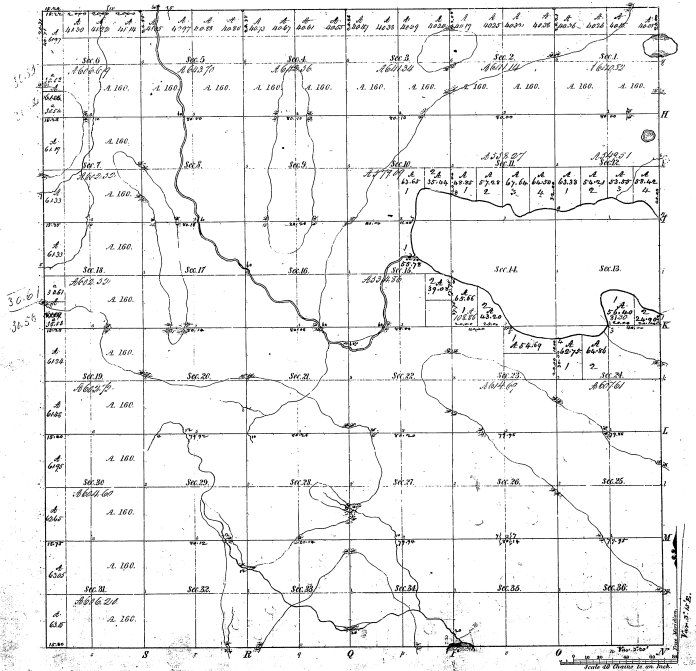

Meanders of part of the Table called for in Secs 18, 19, 20, 29, 30, 31 & 32

Posts	Courses	Dist	Posts	Courses	Dist
2	N 13 W	13.00			
	N 87 W	7.00			
	S 78 W	11.00			
	S 77 W	5.00			
	S 83 W	9.00			
	S 80 W	14.00			
	S 60 W	5.00			
	S 73 W	14.00			
	S 77 W	18.00			
4	S 73 W	6.00			
	S 70 W	18.00			
	S 72 W	8.00			
	S 82 W	8.00			
	S 85 W	11.50			
	S 83 W	8.00			
	S 82 W	17.00			
	S 82 W	6.00			
5	S 76 W	13.00			
	S 77 W	18.00			
	N 82 W	7.00			
	N 84 W	5.00			
7	S 60 W	18.00			
	S 69 W	12.00			
	S 78 W	12.00			
	S 89 W	11.00			
	N 88 W	6.00			
6	N 71 W	14.00			
	N 63 W	7.00			
	N 74 W	12.00			
	N 82 W	7.00			
	N 87 W	9.00			
	N 88 W	9.00			
5	S 81 W	19.00			
	S 84 W	5.00			
	S 76 W	9.00			
4	S 68 W	14.00			
	S 73 W	5.00			
	S 84 W	15.00			
3	S 78 W	9.00			
	S 87 W	9.00			
	N 81 W	14.00			
	N 71 W	6.00			
	N 70 W	6.00			
	N 76 W	14.00			
	N 64 W	13.00			
1	N 71 W	13.50			

Total number of Acres 24,351.68

Surveys Designated	By Whom Surveyed	Date of Contract	Amount of Surveys	When Surveyed.	Plats of Ord and Aux Mer. Rec'd and Examined
Township Lines	Sol. Meredith	Nov. 16. 1840	23. 71. 93	2nd 27. 1840 and Aug 7. 1841	
Subdivisions	"	Aug 11.	60. 68. 69	" " 1840	


Surveyor Generals Office, Cincinnati, Oct. 2. 1841.

S. Sullivan Surv. Gen.l