Original

13-8

Resurvey

TOWNSHIP No. 19 North RANGE No. 1 West Michigan MERIDIAN

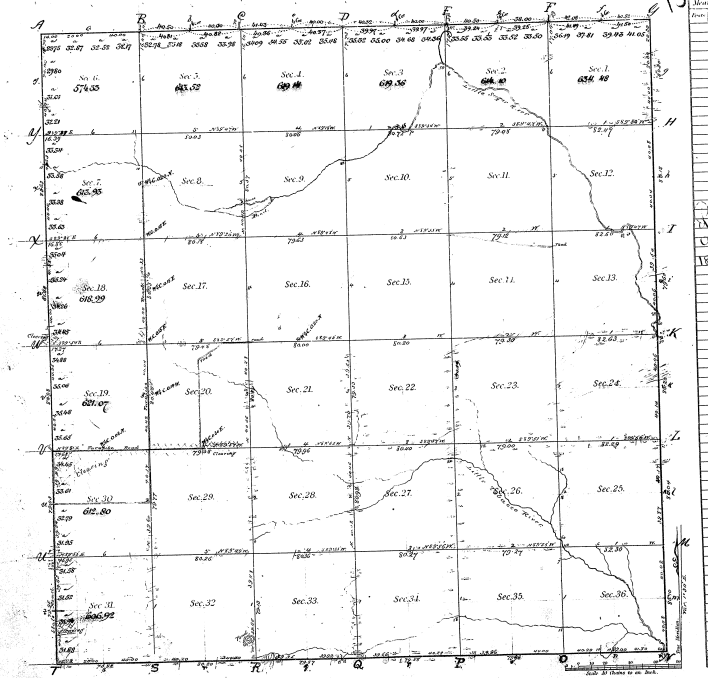

Meanders of								
Posts	Courses	Ch. 12	Posts	Courses	Ch. 12	Posts	Courses	Ch. 12

Resurveyed under the provision of act of Congress, approved July 16, 1877. U. S. Stats. Vol. 19 page 231.

Total number of Acres [illegible]

Surveys Designated	By Whom Surveyed	Date of Contract	Amount of Surveys	When Surveyed
Township lines	S. Platt Merrill	March 21, 1877	2½ - 9¼ - 2½	July 1, 1876, 1877
Subdivisions	do	do	59-61-92	

The above Map of Township No. 19 North of Range No. 1 West of the Michigan Meridian, Michigan, is strictly conformable to the field notes of the survey thereof on file in this office, which have been examined and approved.

Department of the Interior
Surveyor General's Office
General Land Office
August 8, 1877

J. R. Wilmington
Chief Geol. Commissioner