

Surveyed by A.A.Babcock Jr., U.S.Deputy Surveyor, April 9 "Juty 21, 1998 .
under special instructions from the Comt G.L.O, bearing date May 7, 1998.
Scale. 10 chs to an inch.

43-37

Sec.9

13-37-



Department of the Interior

The above plat of an Island in Lake View Dassert, like swith shift of the morthwest quarter of Sec. 8, T.43 N., P.33 W., Mich. Mer, Michigan, is a correct plat of a survey executed by At Balcock, Up. U.S. Deputy Surveyor in pursuance of special instructions from the Commissioner of the General Land Office, bearing date May 7, 1986 and is strictly conformable to the field noise of the survey thereof on file in this office which have been examined and approved.

aching Commissioner and the official J.S. Surveyor General for Michigan

Surveyed by Charles M. Pidgeon, U.S. Deputy Surveyor, July 19 to 21, 1911, under instructions from the Com. G.L.O. bearing date June 19, 1911. Scale 10 Chains to an Inch.

43-37

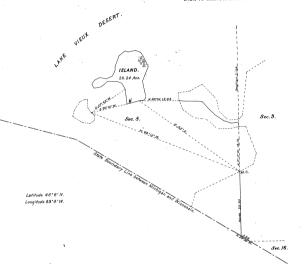

10.0 Department of the Interior. General Land Office, Washington, D.C., December 5, 1911. The above plot of an Island in Lake Vieux Desert. in the west half of the northeast quarter and the east half of the northwest quarter of Section 8, T. 43 N., R. 38 W., Mich. Mer., Michigan, is a correct plat of a survey executed by Charles M. Pidgeon, U.S. Deputy Surveyor, in pursuance of instructions from the Commissioner of the General Land Office bearing date June 19, 1911, and is strictly conformable to the field notes of the survey thereof

on file in this office which have been examined and

approved.

Home of he

Commissioner and ex-officio U.S. Surveyor General for Michigan.