


PLAT OF AN ISLAND
 IN
 Cheney Lake,
 Sec. 2, T. 45 N., R. 45 W., Michigan Mer.
 MICHIGAN.

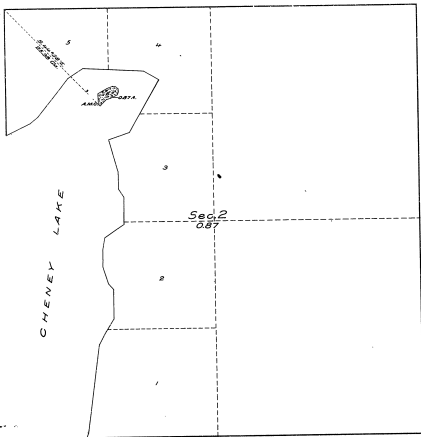

LEGEND.

Scale: 1 inch = 10 chains.

Surveyed by Guy E. Veal, U. S. Cadastral Engineer, on October 9, 1922, under special instructions for Group No. 4, Michigan, dated May 24, 1922, issued by Arthur D. Klider, Associate Supervisor of Surveys, which were approved by the Commissioner of the General Land Office on June 14, 1922.

Area of lands surveyed = 0.87 Acres, not shown upon the plat approved May 21, 1924.
 Areas of previously surveyed lands not shown.

The undersigned hereby certifies that the survey delineated upon this plat has been executed under his general direction and in accordance with the approved special instructions, issued pursuant to authority contained in office letter 504666 "M" JHS, dated February 2, 1922, addressed to the Secretary of the Interior (approved February 4, 1922), and its letter dated February 10, 1922, and that the field notes and the plat of the survey have been carefully verified.

Denver, Colorado.
 January 9, 1924.

William J. Fry
 Supervisor of Surveys.

Department of the Interior,
 General Land Office.

Washington, D. C., January 22, 1924.

The above plat of an island in Cheney Lake in Section 2, Township 45 North, Range 45 West, of the Michigan Meridian, in the State of Michigan, is strictly conformable to the field notes of the survey thereof, on file in this office, which have been examined and approved.

William J. Fry
 Commissioner and ex officio
 U. S. Surveyor General for Michigan.

42-38

42-38