Township No. 46 N. Range No. 42 W. Mer. Mich.

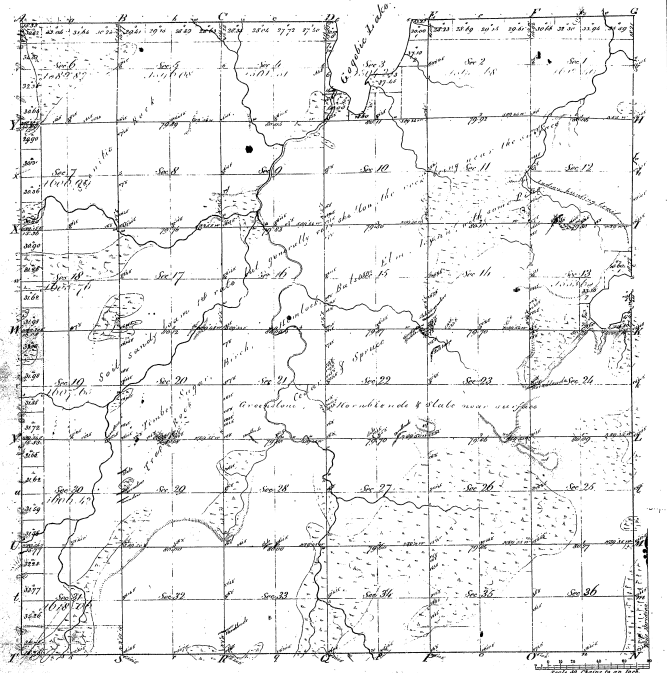

Meanders of								
Posts	Courses	Ch. Lks.	Posts	Courses	Ch. Lks.	Posts	Courses	Ch. Lks.

42-34

Meanders
3 miles 56 chains 20 links

42-34

Total number of Acres 22225.36

Surveys Designated.	By Whom Surveyed.	Date of Contract.	Amount of Surveys M.	Ch.	Lks.	When Surveyed.	When Charged in the Sub. Gen.l acc.t
Township lines.	W. A. Burch	April 27 1847	11	76	96	3rd Quart 1847	
Subdivisions.	A. Merryweather	May 12th 1851	63	04	15	24th Quart 1851	

The above Map of Township No. 46 North of Range No. 42 West of the Principal Meridian, Michigan is strictly conformable to the field notes of the survey thereof on file in this Office, which have been examined and approved.

Surveyor General's Office
Detroit Dec. 10 1851.

Charles Noble Surv.r Genl.