41-1

Township No. 55 N. Range No. 36 West Mer. Mich.

41-1

Meandere of									
Pulls	Courses	Ch.s	Lks	Pulls	Courses	Ch.s	Lks	Pulls	Courses	Ch.s	Lks

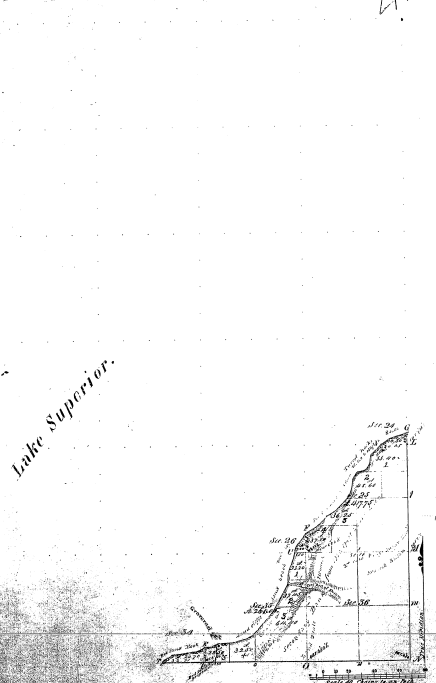

Total number of Acres 1556.86

Surveys Designated	By Whom Surveyed	Date of Contract	Amount of Surveys Ch.s Lks	When Surveyed	When Charged in the Sec.y Gen.l acct
Township Lines	[illegible]	Sept. 3rd 1846	4 [illegible] 15	1st qr. 1845	
Subdivisions	[illegible]	Apl. 22 1846	8 13 16	2nd qr. 1846	

The above Map of Township No. 55 North of Range No. 36 West of the Principal Meridian, [illegible] is [illegible] in the field notes of the survey thereof in file in this Office which have been examined and approved.

Surveyor General's Office
Detroit Octr. 16th 1847.

Lucius Lyon, Sur. Genl.