

Township N.º 17 N., Range N.º 9 East Mer. (Mich.)

M. L. Marlet, 17.º 9.º E. Mich.



S A G A N A W B A Y .



Foot	Course	Dist	Foot	Course	Dist	Foot	Course	Dist
2	N 75 E	120						
	N 75 W	120						
	S 75 W	120						
	S 75 E	120						
	N 75 W	120						
	N 75 E	120						

241-5
245

Survey Requested	By Whom Surveyed	Name of Captain	Number of Sections	When Surveyed	When Returned to the Surveyor's Office
Friendship lines	John Marshall	S. H. H. D. D.	2, 45, 72	1 st of 1870	
Subdivisions	Same		4, 23, 27		

The above, Map of Township N.º 17 N., of Range N.º 9 East of the Principal Meridian, Michigan, is a plat, comprising the full area of the survey shown on file in this Office, which has been examined and approved.
Surveyor General's Office, P. O. Springs, Mich.
Columbus, May 25, 1880.


Township No 17 N, Range No 9 East Mer Mich.

93

24 = 5

24.5

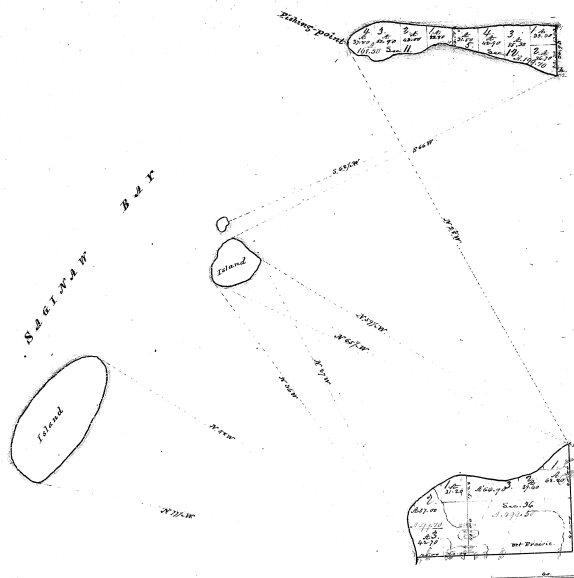


