Township No. 17 N. Range No. 12 E. Mer. Mich.

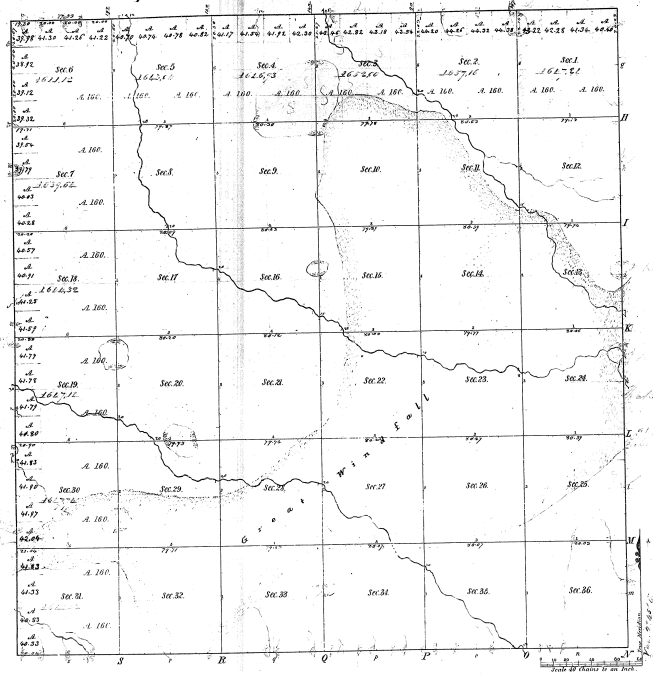

Meanders of							
Poles	Courses	Dist.	Poles	Courses	Dist.	Poles	Courses	Dist.

25-5

Total number of Acres 23,040

Surveys Designated	By Whom Surveyed	Date of Contract	Amount of Surveys	When Surveyed	When Plat of Ist and 2d sts. on the Sur. Gen.'s Off.
Township lines	[illegible]	[illegible]	[illegible]	[illegible]	[illegible]
Subdivisions	I. [illegible]	15th Feb. 1835	22.07-20	[illegible] 1835	4th [illegible] 1835

The above Map of Township 17 N. of Range No. 12 E. of the Principal Meridian, Michigan, is strictly conformable to the field notes of the survey thereof on file in this Office, which have been examined and approved.

Surveyor General's Office,
Cincinnati.

Sur. Gen.l