

Township N^o 18 N., Range N^o 11 E. Mer. Mich.

24-2


24-2



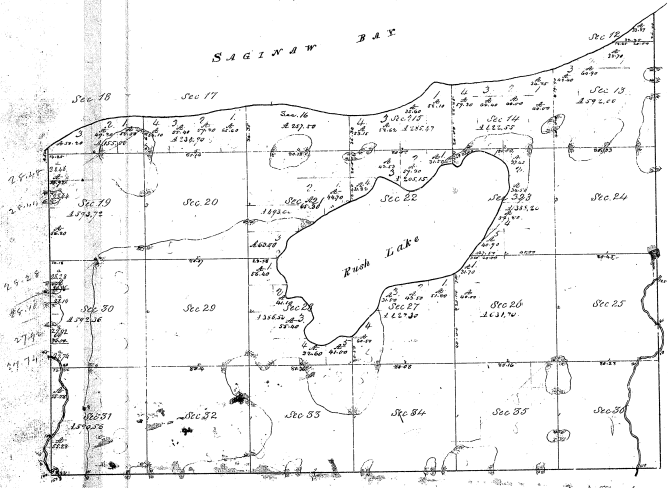


