
Township Nº 24.V. Range Nº 6 E Mer. Mich. Meanders of

Posts Courses Chest Posts Courses Child: Posts Courses Cheld. Jun or 44.75 A17.99 Acres 624.36 A. 16C. * .4. 16C. A 160. A 100. A 100. Séc.II. Sec.12. A. 160. Sec.14. Acres 608.40 A 160. A 160. A 160. A. 160. Sec. 31. Sec. 35. A. 160. Total number of Acres. 32, 683.84 19 24 North of Range 19 6 Gast of the Surveys Designated By Whom Surveyed Date of Contract Amount of Surveys Whon Surveyed the Inc Con D. and Trinning lines Look the flow bety 10 1837 15 5 10 12 g 1838 1 3 1839 subdivisione Light the Mullett Clerity 1844 59 have 9 1 18 1845

TOWNSHIP Nº24 NORTH, RANGE Nº 6 EAST OF THE MICHIGAN MERIDIAN, MICHIGAN.

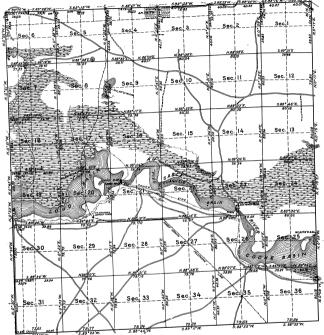




Acres

MEMORANDUM.

THIS PLAT OF THE RESURVEY OF TOWNSHIP 24 NORTH. RANGE 6 EAST, MICHIGAN MERIDIAN, MICHIGAN, DELINE-ATES A RETRACEMENT AND REESTABLISHMENT OF THE LINES OF THE ORIGINAL SURVEY AS SHOWN UPON THE PLAT APPROVED FEBRUARY II, 1845, IN THEIR TRUE ORIGINAL POSITIONS ACCORDING TO THE BEST AVAILABLE EVIDENCE OF THE POSI-TION OF THE ORIGINAL CORNERS. ALL DIFFERENCES BETWEEN THE MEASUREMENTS SHOWN ON THE ORIGINAL PLAT AND THOSE DERIVED IN THE RETRACEMENT HAVE BEEN DISTRIBUTED PRO-PORTIONALLY BETWEEN ACCEPTED CORNERS IN ACCORDANCE WITH SURVEYING RULES. REFERENCE WILL BE MADE TO THE ORIGINAL PLAT FOR THE SHOWING OF AREAS OF THE VARIOUS SUBDIVISIONS.

THE UPLAND IN THIS TOWNSHIP HAS A SCATTERING GROWTH OF JACK PINE AND BLACK OAK, OF LITTLE VALUE. IN THE SWAMPS THERE IS A FAIR GROWTH OF CEDAR AND TAWARACK, MOSTLY YOUNG TIMBER AND OF LITTLE VALUE. A FEW NORWAY AND WHITE PINES ARE ALSO FOUND IN THE TOWNSHIP. THE CONSUMERS POWER COMPANY HAS A FEW SWALL PLANTATIONS OF YOUNG WHITE PINE ALONG THE SOUTH SIDE OF THE AU SARLE RIVER.

> DEPARTMENT OF THE INTERIOR GENERAL LAND OFFICE DENEMAL LAND OFFICE
>
> We shington, D.C., May 9, 1929
> The survey represented by this plat, having been correctly executed in accordance with the requirements of law and the regulations of this office, is hereby accepted.

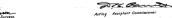

105 0 10 20 40 B

Area Surveyed, Scale: 40 Chains to an Inch. WHEN SURVEYED BEGUN MLS. CHS.

LINES DESIGNATED BY WHOM SURVEYED NO DATE 17 73.85 Exterior GUY R. VEAL JUNE 3. AUG. 23. U.S.C.ENGINEER MAY 13, 59 43-52 Subdivisional 1927. 1927. 1927. W. W. BANDY Meander Miscellaneous U.S.SURVEYOR.

Utfice of U.S.Supervisor of Surveys
Denver, Colorado, Feb. 6, 1928.
The above plot of Tomnship No.24 North, Range No.6 East, of the Michigan Meridion, Michigan is strictly conformable to the field notes of the Survey thereof which have been examined and approved.

Office of U.S. Supervisor of Surveys

Mean Magnetic Declination,