44-28

Township No. 44 N. Range No. 33 W. Mer. Mich.

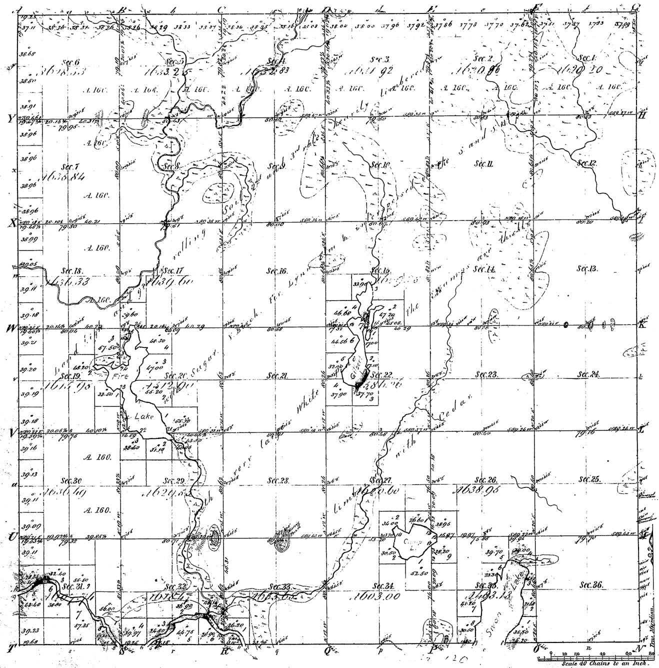

Meanders of								
Posts	Courses	Ch. Lk.	Posts	Courses	Ch. Lk.	Posts	Courses	Ch. Lk.
			Meanders, m. ch. lk. 15. 35. 46					

Total number of Acres 22424.38

Surveys Designated	By Whom Surveyed	Date of Contract	Amount of Surveys	When Surveyed	When pd. for and chd. in the Sur. Gen.ls acct.
			M. Chs. Lks.		
Township lines	Austin Burt	Sept 7 1847	11. 78. 18	3rd Quar 1846	
Subdivisions	Guy H Carleton	April 10 1851	74 30 92	2nd Quar 1851	

The above Map of Township No. 44 North of Range No. 33 West of the Principal Meridian Michigan is strictly conformable to the field notes of the survey thereof on file in this Office, which have been examined and approved.

Surveyor General's Office
Detroit Jan 10. 1852

Charles Noble
Sur. Genl.