Township N. V North, Range 6 W XII West Mer. (Mic. Ter.)

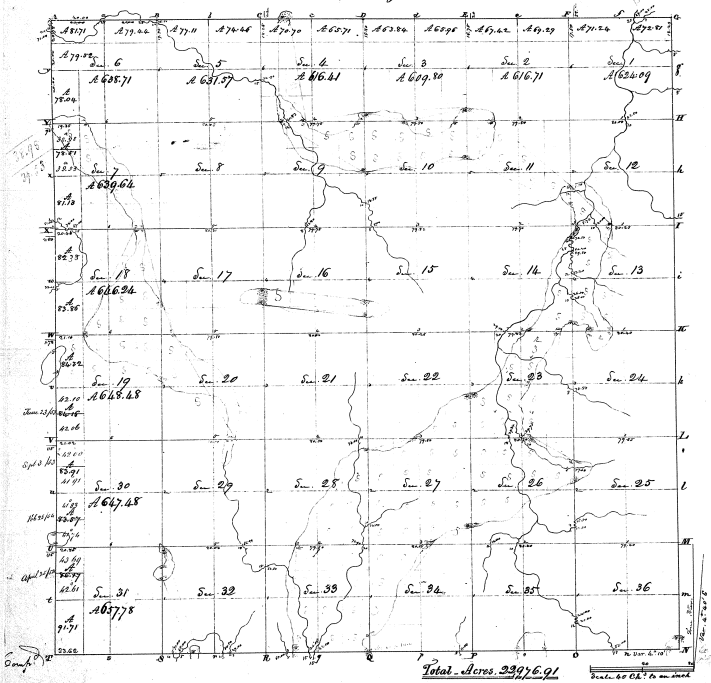

Total Acres. 23976.91

Surveys designated	By whom Surveyed	Date of Contract	Am't of Survey Ch. L.	When Surveyed	When Ret'd to Gen'l Land Office	Remarks
S. Boundary	L. Lyon			4th qr. 1831	4th qr. 1831	
S. D.	Same	25 May. 1830		4th qr. 1831	1st qr. 1832	
N & W Bdries	Same	" " "		do " "	do " "	
Subdivision	Same	" " "	39,720.63	" " "	" " "	

The above Map, of Township N° 5 North, of Range N° 12 W of the Principal Meridian, Michigan Territory, is strictly conformable to the field Note of the survey thereof on file in this office, which have been examined and approved.

Surveyor Generals Office
Cincinnati, March 26th 1834

M. T. Williams
Sur. Gen.l

Contents

Sections	Acres	Hds	Sections	Acres	Hds

7-24

7-24