Township N.º 57 N. Range N.º 32 W. Mer. Mich.

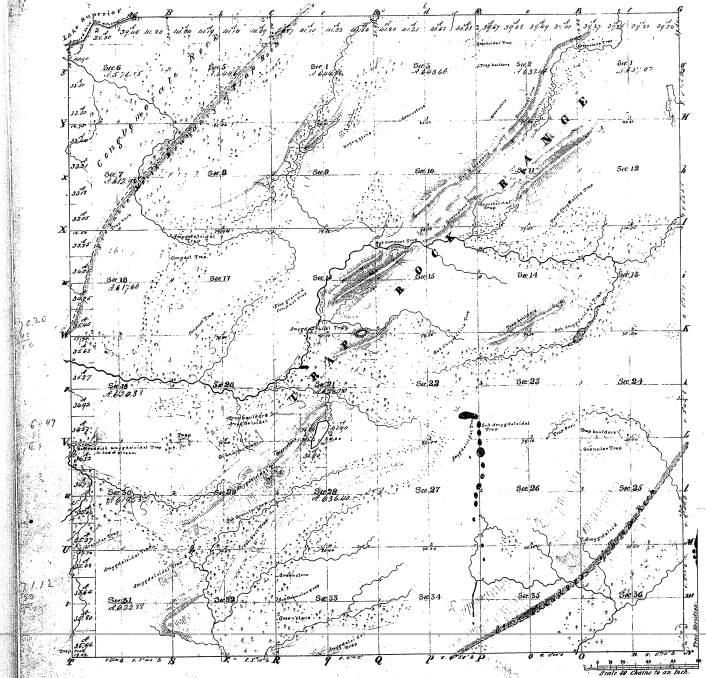

Meanders of

Point	Courses	32 Links	Point	Courses	32 Links	Point	Courses	32 Links
Meanders of Lake on the [illegible] Boundary of N. on [illegible] W. on [illegible] Lake								
1	S 33 E	6.00						
	S 1 15 E	7.00						
	S 24 E	7.50						
	S 91 E	9.00						
	S 10 E	5.00						
	S 35 W	4.00						
2	S 25 W	6.50						
	S 51 W	5.00						
3	N 12 E	6.00						
Meanders of Lake on North Boundary also East on N. Boundary down to [illegible]								
4	S 40 E	10.00						
	N E	[illegible]						
	S 20 E	12.50						
	S 30 E	8.00						
	S 26 E	5.50						
5	S E E	21.00						
		12.50						
		[illegible]						

40-34

Surveys Designated.	By Whom Surveyed.	Date of Contract.	Amount of Surveys at 1.25 per Ac.	When Surveyed.	When Changed in the Surveyor Gen.'s Office.
Township Lines	Wm. M. Smith	January 1846		3rd qr. 1845	
Subdivisional	O. Hampton	January 1846	61 14.11	3rd qr. 1845	

Total number of Acres 22,166.17

The above Map of Township N.º 57 North of Range N.º 32 West of the Principal Meridian Michigan is strictly conformable to the field notes of the survey thereof on file in this Office which have been examined and approved.

Surveyor Generals Office, Detroit, May 5, 1846.

Lucius Lyon, Surv. Genl.