40-13

Township No. 64 N Range No. 37 W Mer: Mich.

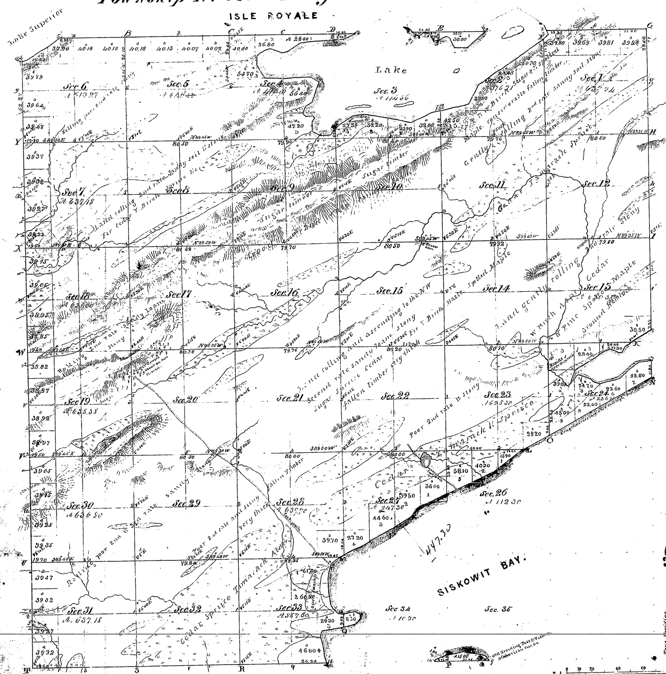

Meanders of								
Posts	Courses	Chs. Lks.	Posts	Courses	Chs. Lks.	Posts	Courses	Chs. Lks.

40-13

Total number of Acres 18015.22

18,2015.02

Surveys Designated.	By Whom Surveyed.	Date of Contract.	Amount of Surveys. M. Chs. Lks.	When Surveyed.	When Charged in the Sur. Genl's acct.
Township lines.	Wm Ives	April 23 1847	6. 24. 19	2q. 1848	
Subdivisions.	Wm Ives	1847	63. 12. 15	2q. 1848	

The above Map of Township No. 64 North of Range No. 37 West of the Principal Meridian, Michigan is strictly conformable to the field notes of the survey thereof on file in this Office which have been examined and approved.

Surveyor General's Office,
Detroit Nov. 6th 1848

Lucius Lyon, Surr. Genl