Township N° 39 N., Range N° 12 West Mer. (Mich.)

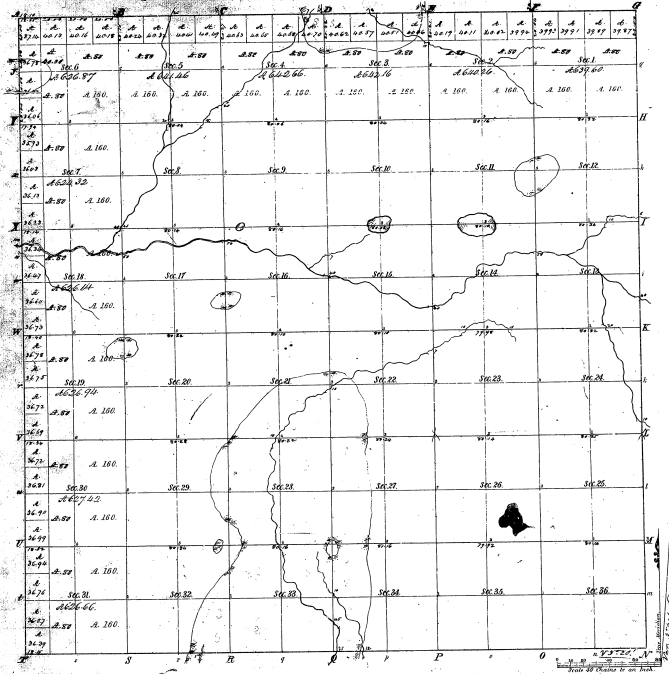

Meanders of

Posts	Courses	Ch. Lks.	Posts	Courses	Ch. Lks.	Posts	Courses	Ch. Lks.

11-8

Total number of Acres 22964.49

Surveys Designated	By Whom Surveyed	Date of Contract	Amount of Surveys	When Surveyed	When Plat was returned to the Surveyor Gen.l's Office	When Plat was filed in the Local Office
Township lines	Augustus Elliott	April 24 1838				
Subdivisions	Augustus Elliott	April 24 1838				

The above Map of Township N° 39 North of Range N° 12 West of the Principal Meridian Michigan is strictly conformable to the field notes of the survey thereof on file in this Office, which have been examined and approved.

Surveyor Generals Office
Detroit Mich. Feb. 20th 1839

S. S. Baxter Surv. Gen.