Re Survey

Township No. 29 N. Range No. 11 W Mer. Mich.

16 4 1

16-7

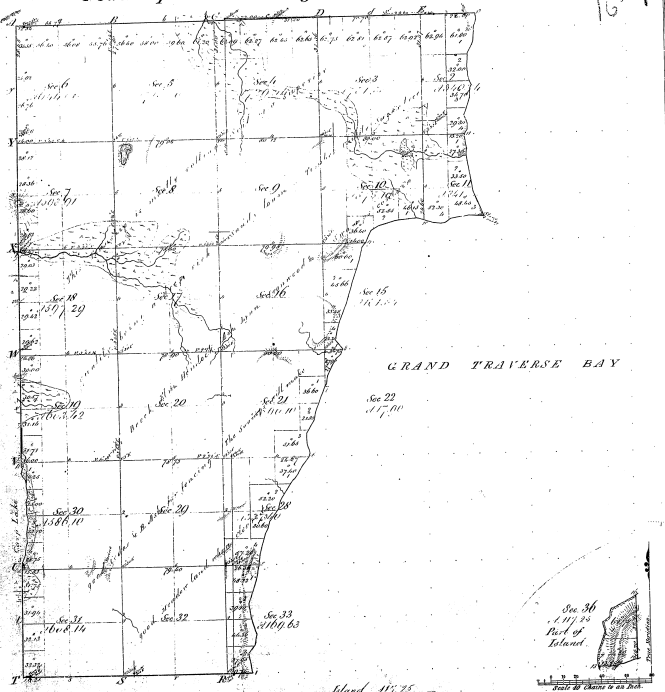

Island 117.25

Total number of Acres 22,022.00

Survey Designated.	By Whom Surveyed.	Date of Contract.	Amount of Surveys. M.	Ch.	Lks.	When Surveyed.	When Charged in the Gen'l Land Office.
Township Lines.	Orange. Rice & Co.	Dated Nov. 1. 1850.	2	15	46	1850.	
Subdivisions.	Orange. Rice & Co.		42	20	68	1850.	

The above Map of Township No. 29 North of Range No. 11 West of the Principal Meridian, Michigan, is strictly conformable to the field notes of the survey returned from the Office, which have been examined and approved.

Surveyor General's Office,
Detroit July 31st 1851.

Charles Hill Sur. Genl.