Reservoy

Township No. 31 N. Range No. 12 W. Mer. Mich.

48-23

Meanders of								
Posts	Courses	Ch's Lks	Posts	Courses	Ch's Lks	Posts	Courses	Ch's Lks

Meanders of M. H. C. 1st l.

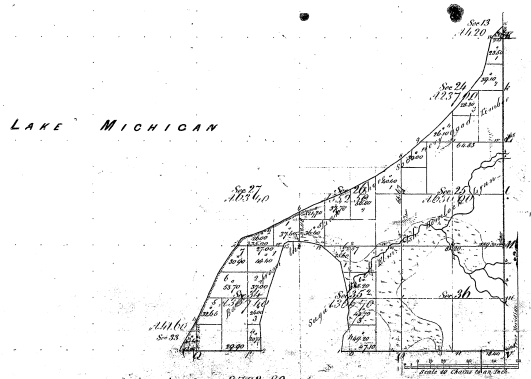

Total number of Acres 2702.80

Surveys Suspended.	By Whom Surveyed.	Date of Contract.	Amount of Surveys M.	Ch's.	Lks.	When Surveyed.	When Accepted by the Surv. Genl's office.
Township	Orange Risdon	Verbal Feb 26 1857	2	36	44	2nd Quar 1857	
Subdivisions	C. & S. Wadsworth	Instructions	3	07	52	3rd Quar 1857	
	Orange Risdon	Verbal Aug 28 1857	10	29	68	4th Quar 1857	

The above Map of Township No. 31 North of Range No. 12 West of the Principal Meridian Michigan is strictly conformable to the field notes of the survey thereof, on file in this office, which have been examined and approved.

Surveyor General's Office
Detroit Sept 27 1857

[signature] Surv. Genl.