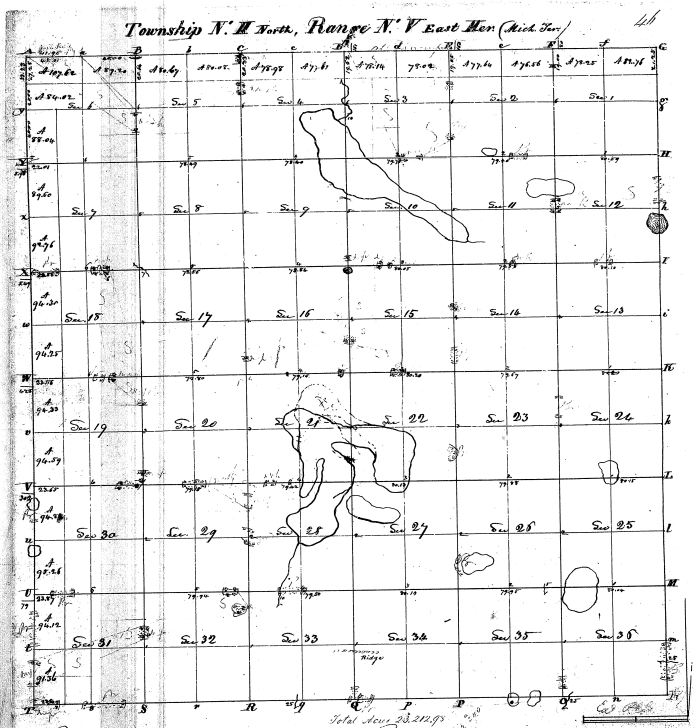

Pursuant to a Contract with Canal Instructions from Edward Tiffin Surveyor General of the United States, bearing date the day of I have Surveyed said out Canal through the Above Township, and do Certify that the Lines and Meanders of the Said Township, as are represented on Said Plat, Canal described in the Field Notes and returned with the Plat into this Surveyor Generals Office — Certified this 9th October 1823 —

S. Sibley D. S.