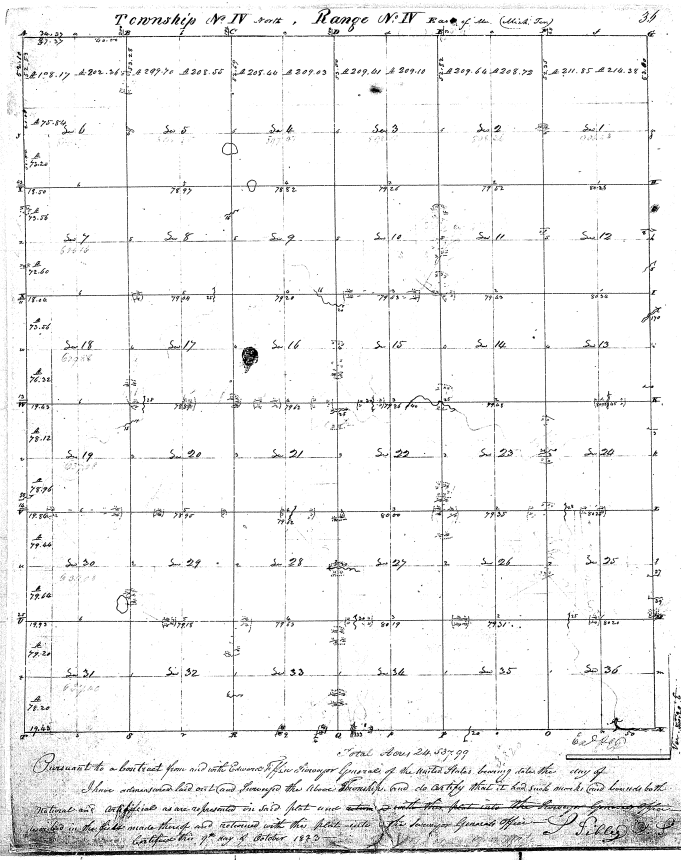
Sec. 6 Sec. 5 Sec. 4 Sec. 3 Sec. 2 Sec. 1
Sec. 7 Sec. 8 Sec. 9 Sec. 10 Sec. 11 Sec. 12
Sec. 18 Sec. 17 Sec. 16 Sec. 15 Sec. 14 Sec. 13
Sec. 19 Sec. 20 Sec. 21 Sec. 22 Sec. 23 Sec. 24
Sec. 30 Sec. 29 Sec. 28 Sec. 27 Sec. 26 Sec. 25
Sec. 31 Sec. 32 Sec. 33 Sec. 34 Sec. 35 Sec. 36
Total Area 24.037.99
I have subdivided said and Township the above Township, and do certify that the lines, courses, and

24-25

29-28