36-21

Township No. 45 N. Range No. 12 W. Mer. Mich.

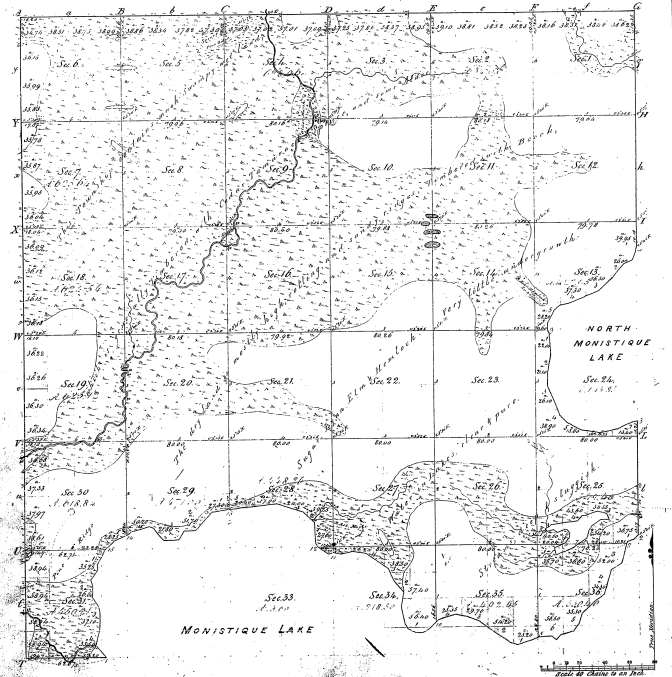

Meanders of								
Posts	Courses	Ch^s Lk^s	Posts	Courses	Ch^s Lk^s	Posts	Courses	Ch^s Lk^s
36-21								
Total Meanders 12^m 74^ch 27^lk								

Total number of Acres 19,407.08

Surveys Designated.	By Whom Surveyed	Date of Contract.	Amount of Surveys M. Ch^s Ch^s	When Surveyed.	When Charged in the Surv^r Genl's acct
Township Lines.	William A. Burt.	April 1. 1841.	4. 84. 62.	1st Quarter 1841.	
Subdivisions.	Cary H. Carleton.	July 14. 1849.	164. 52. 80.	3rd Quarter 1849.	

The above Map of Township No. 45 North of Range No. 12 West of the Principal Meridian Michigan is hereby conformable to the field notes of the survey thereof on file in this Office, which have been examined and approved.

Surveyor General's Office.
Detroit April 15. 1850.

Charles Noble Sur^r Genl

Island
Township No. 45 N. Range No. 12 W. Mer. Mich.

36-21

② 36-21

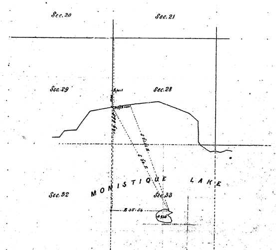

Meanders of

Posts	Courses	Chs. Lks.	Posts	Courses	Chs. Lks.	Posts	Courses	Chs. Lks.
	Meander	42 chs	95 lks					

Scale 40 Chains to an Inch.

Total number of Acres 9.36

Surveys Designated.	By Whom Surveyed.	Date of Contract.	Amount of Surveys. M. Chs. Lks.	When Surveyed.	When Charged in the Surr. Genl's acct.
Township lines					
Subdivisions,	Geo. H. Cannon		0 42 95	3d Quar. 1854	

The above Map of Township No. 45 N of Range No. 12 West of the Principal Meridian of Michigan is strictly conformable to the field notes of the survey thereof on file in this Office, which have been examined and approved.

Surveyor General's Office,
Detroit September 26, 1854.

Leander Chapman
Surr. Genl.