Township N°42N. Range N°2W. Mer. Mich.

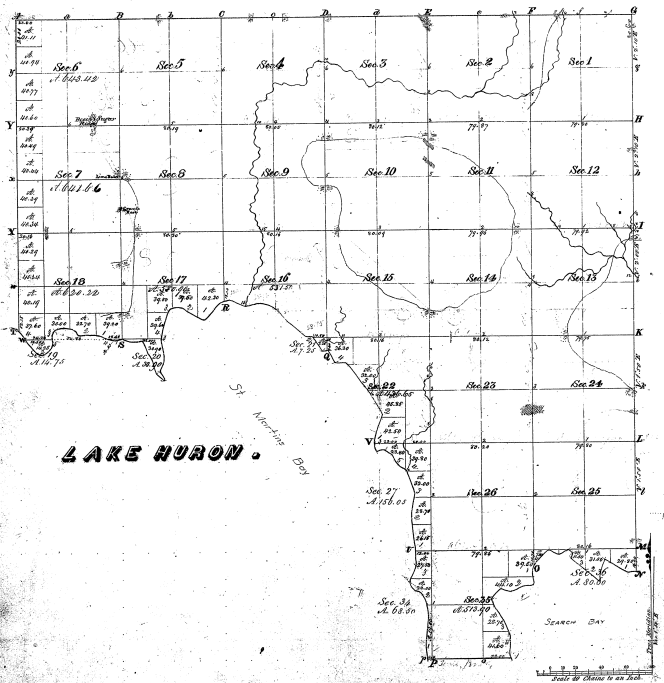

Meanders of								
Point	Courses	Dist Lks	Point	Courses	Dist Lks	Point	Courses	Dist Lks

33-38

33-38

Total number of Acres 15,176.30

Surveys Designated.	By Whom Surveyed.	Date of Contract.	Amount of Surveys Ex. Cat. Lks	When Surveyed.	When Changed to the Surveyed Area
Township lines.	Sept. A. Platt	June 7th 1836		1st qr 1845	
Subdivisions.	A. St. Mallett	April 28th 1845	51.03.31	1st qr 1845	

The above Map of Township N°42 North of Range N°2 West of the Principal Meridian, Michigan, is strictly conformable to the field notes of the survey thereof on file in this Office, which have been examined and approved.

Surveyor Generals Office, Detroit, December 1st 1845

Lucius Lyon, Surv. Gen.