Township No. 42 N. Range No. 4 W. Mer. (Mich.)

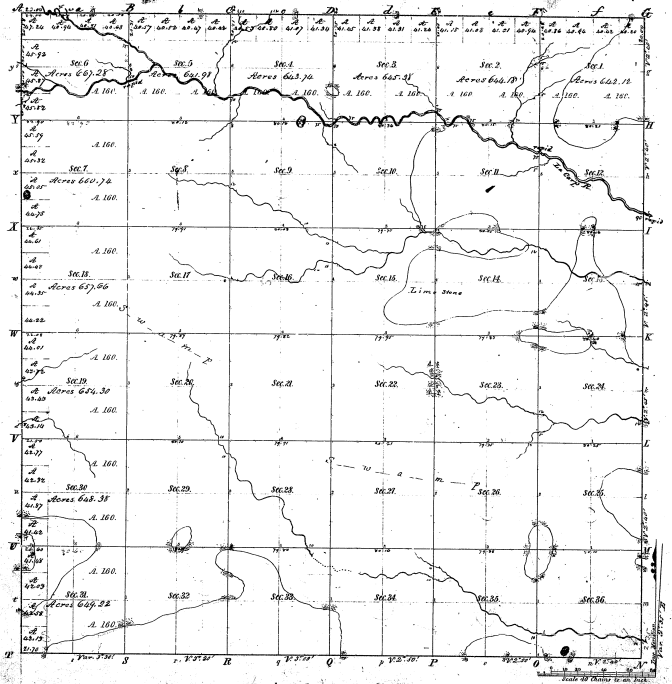

Meanders of

Posts	Courses	Ch. Lk.	Posts	Courses	Ch. Lk.	Posts	Courses	Ch. Lk.

48-34

Total number of Acres 23,154.98

Surveys Designated	By Whom Surveyed	Date of Contract	Amount of Surveys	When Surveyed	
Township Lines	Wells A.B.	Jany 14th 1845	M. Ch. Lks.	2nd Jany 1845	
Subdivisions	Sumy H. Mullett	April 2d 1845	68. 11. 75	2d Jany 1845	

(The above Map of Township No. 42 North of Range No. 4 West of the Principal Meridian Mich. is strictly conformable to the field notes of the Survey thereof on file in this Office, which have been examined and approved.

Surveyor General's Office
Detroit July 26th 1845

Lucius Lyon
Sur. Genl.

Reg. Copy