Township No. 44 N. Range No. 9 W. Mer. Mich.

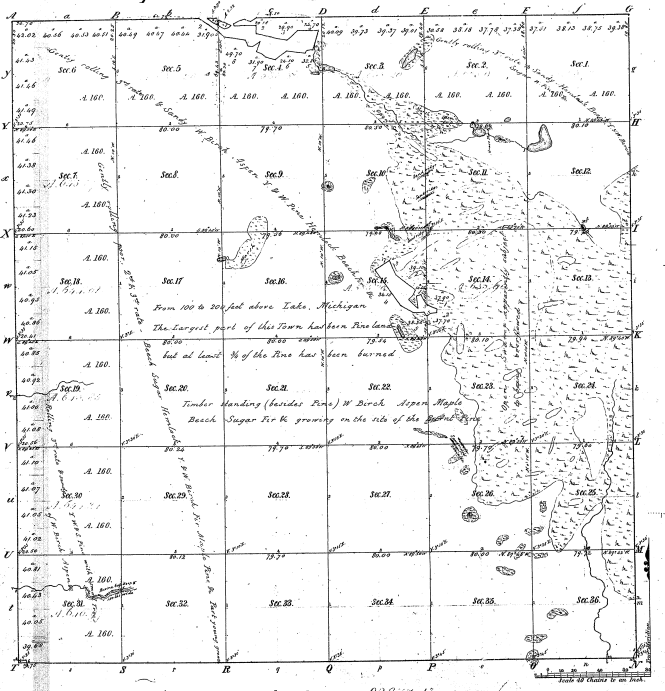

Meanders of								
Posts	Courses	Ch.s Lk.s	Posts	Courses	Ch.s Lk.s	Posts	Courses	Ch.s Lk.s
35-31								

35-31

Total number of Acres: 22877.13

Surveys Designated	By Whom Surveyed	Date of Contract	Amount of Surveys	When Surveyed	When p.d for and ch.d to the Sur.r Gen.l acc.t
Township lines	Wm. J. Hurt	6th Feb. 1844	M. Ch.s Lks.	Sept. 1844	
Subdivisions	Wm. Ives	June 7. 1844	65. 11. 50	3 Sept. 1844	

The above Map of Township No. 44 North of Range No. 9 West of the Principal Meridian Michigan is strictly conformable to the field notes of the survey thereof on file in this Office, which have been examined and approved.

Surveyor General's Office.
Detroit Aug. 23. 1844.

Lucius Lyon. Sur.r Gen.l