J. T. Higbee 23-13 Mich.

17-25

Township No. 23 N., Range No. 13 West Mer. (Mich.)

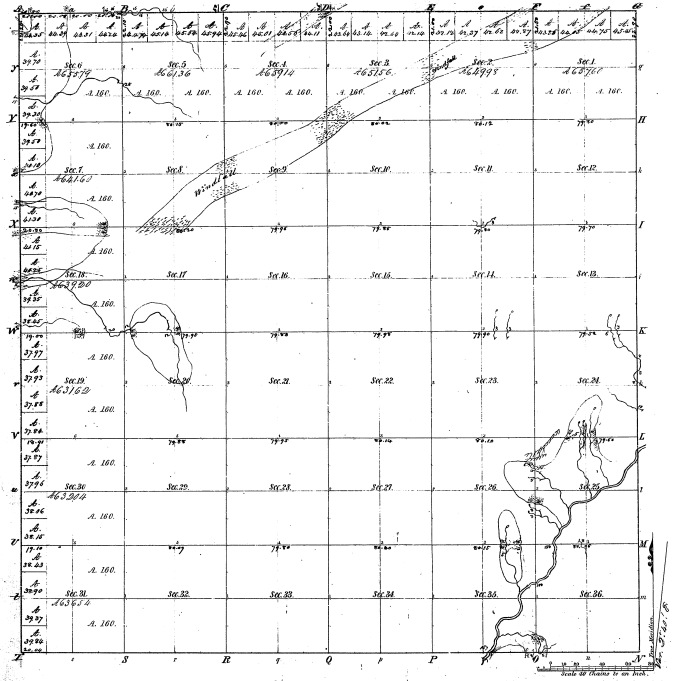

Meanders of							
Posts	Courses	Ch.s Lk.s	Posts	Courses	Ch.s Lk.s	Posts	Courses	Ch.s Lk.s

17-25

Total number of Acres 23,116.43.

Surveys Designated	By Whom Surveyed	Date of Contract	Amount of Surveys	When Surveyed	When pd. for and ch.d in the Surv. Gen.l Acct.
Township lines	John Bimbo	Nov. 4th 1836	M. 24. Ch.s 05. Lks 19	6th Aug. 1837	3rd Aug. 1838
Subdivisions	Same	" " 1839	60. 06. 91	4th Aug. 1839	4th Aug. 1839

The above Map of Township No. 23 North of Range No. 13 W. of the Principal Meridian Michigan is strictly conformable to the field notes of the survey thereof on file in this Office which have been examined and approved.

Surveyor General's Office, Cincinnati, Sept. 9th 1840

C. S. Hall Spec. Gen.l

Compilation copy made

A. K.

Register copy made

A. K.

16

11