39-29

Township No. 47 N. Range No. 28 W. Mer. Mich.

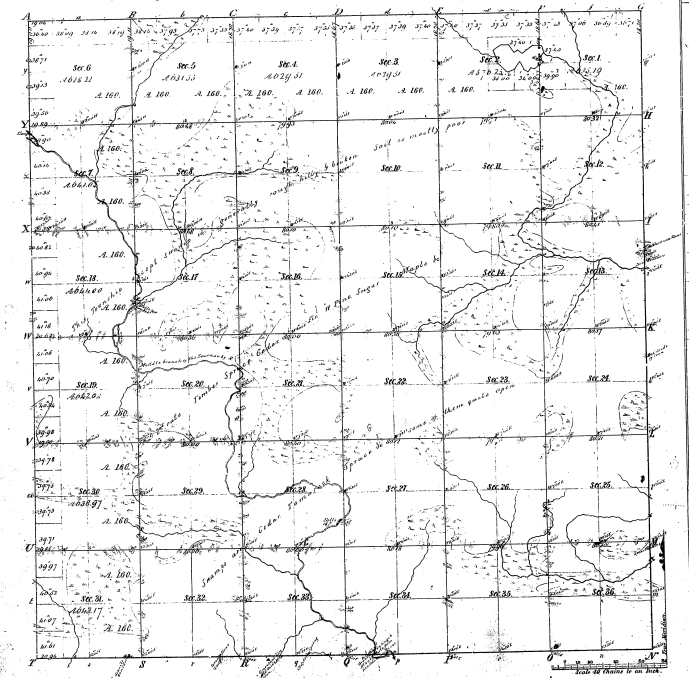

Meanders of								
Posts	Courses	Ch.s Lk.s	Posts	Courses	Ch.s Lk.s	Posts	Courses	Ch.s Lk.s
39-29								
				Meanders				
				M. Ch. Lk.				
				L. 47. 95				

Total number of Acres 22929.30

Surveys Designated	By Whom Surveyed	Date of Contract	Amount of Surveys			When Surveyed	When p.d for and ch.d in the Surv.r Gen.ls acc.t
			M	Ch.s	Lks		
Township lines	Wm. John Schuller Bust	Sept. 7th 1846	4	79	25	2nd qr 1846	
Subdivisions	John Bust	Bond 23 Feb. 1849	61	31	97	2nd qr 1848	

The above Map of Township No. 47 North of Range No. 28 West of the Principal Meridian Michigan is strictly conformable to the field notes of the Survey thereof on file in this Office, which have been examined and approved.

Surveyor General's Office
Detroit March 15 1849

Lorenzo Lyon Sur. Gen.l