Township. N.o 49 N. Range. N.o 27 W. Mer. Mich.

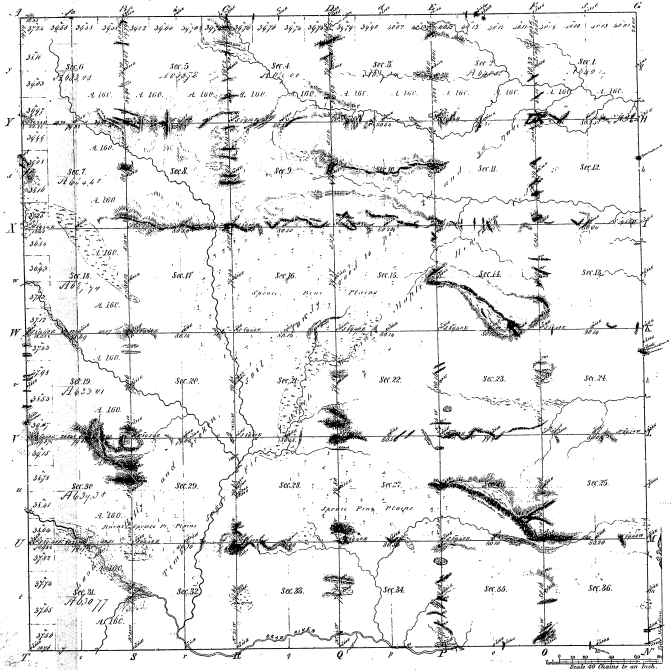

Meanders of
Posts Courses Dist.s Posts Courses Dist.s Posts Courses Dist.s

Surveys Designated	By Whom Surveyed	Date of Contract	Amount of Surveys	When Surveyed	When approved and sent to the Surr. Gen.l's Office
			M. Chs. Lks.		
Township lines	D. Haughton	June 28.th 1844	5. 80. 00	2.nd Quar. 1845	
Subdivisions	Martin M. Hall		66. 36. 32	3.d Quar. 1853	
	S.D. Hall, Martin Burr	April 7.th 1846	5. 72. 76	3.d Quar. 1855	

Total number of Acres 22,946.42

The above Map of Township No 49 N of Range No 27 W of the Principal Meridian of Michigan is hereby conformable to the field notes of the survey thereof on file in this Office which have been examined and approved.

Surveyor Generals Office
Detroit April 2.d 1856

Deputy Surveyor

31-2-1