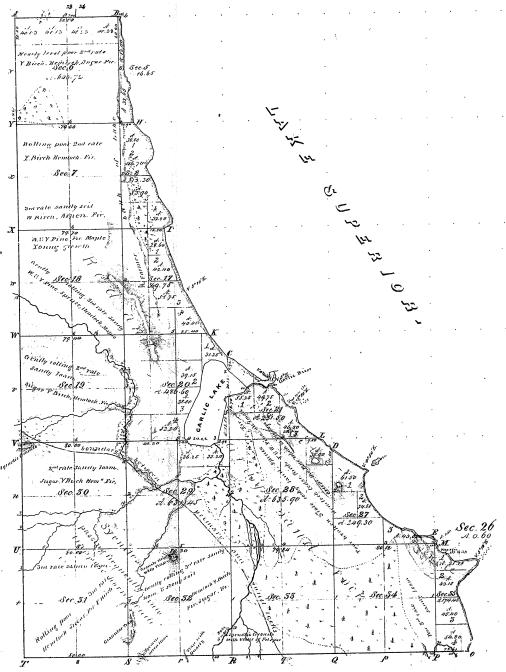Township No. 50 N. Range No. 26 W. Mer. Mich.