Township N°52 N. Range N° 28 W. Mer. Mich.

39-5

LAKE SUPERIOR.

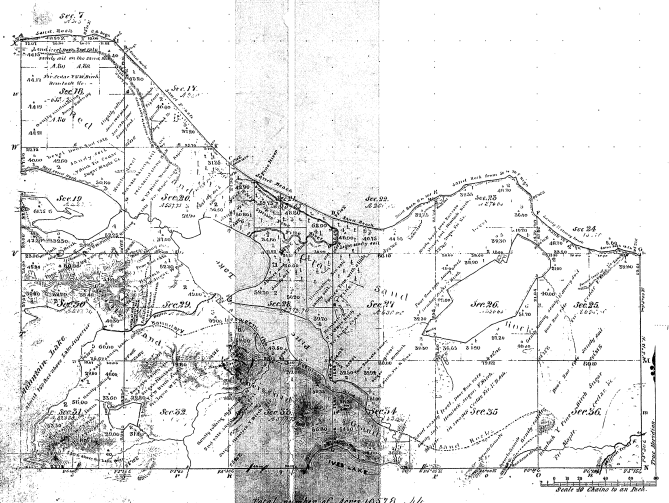

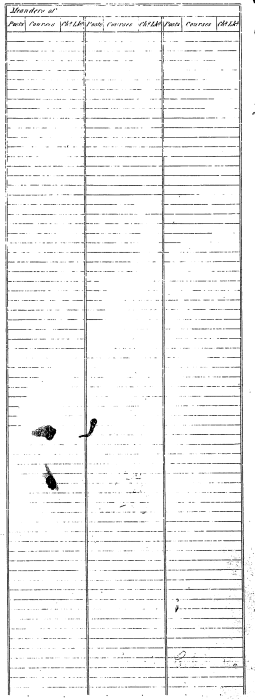

39-5

Total number of Acres 16379.44

Surveys Designated.	By Whom Surveyed.	Date of Contract.	Date of Return.	When Changes in the Surf. Lines &c.
Township lines	Wm. A. Burt			
Subdivisions.	Hallantt & Ives	Sept. 5th 1844		

The above Map of Township N° 52 North of Range N° 28 West of the Principal Meridian, Michigan, is strictly conformable to the field notes of the survey thereof on file in this Office, which have been examined and approved.

Surveyor Generals Office,
Detroit Nov. 25th 1845

Lucius Lyon, Surv. Genl