Township No. 19 N. Range No. 15 West. Mer. Mich.

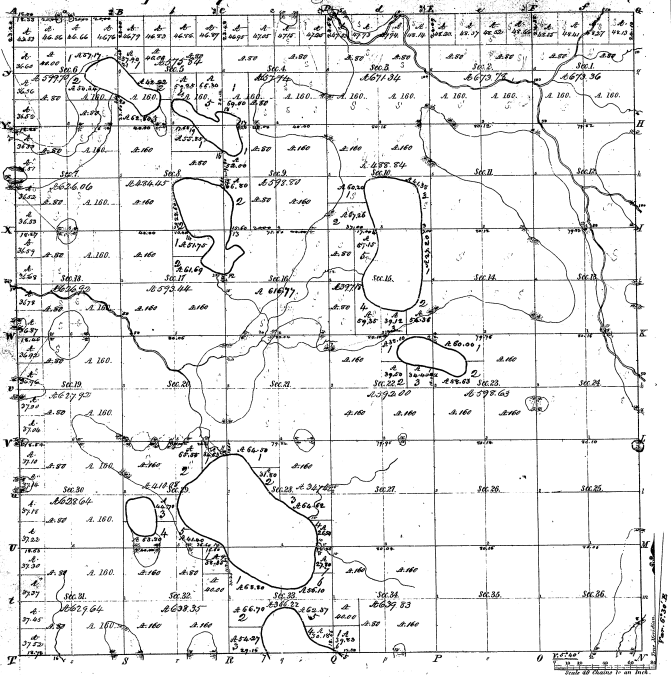

Meanders of Lakes:

Posts	Courses	Dist.	Posts	Courses	Dist.
Lake in Section 29				N 42½ W	10.00
Big Portage Lake	N 23½ W	10.00		N 15 W	18.00
1	N 22½ W	6.00		N 30 W	4.00
2	N 15 W	12.00		N 45 W	12.00
3	N 6 E	8.00		N 67½ W	16.00
4	N 22½ E	16.00		N 82½ W	10.00
5	N 42½ E	16.00	11	N 82½ W	20.00
6	N 82½ E	8.00	12	N 67½ W	8.00
7	N 67½ E	8.00		N 45 W	8.00
