Township No. 38 N. Range No. 29 W. Mer. Mich.

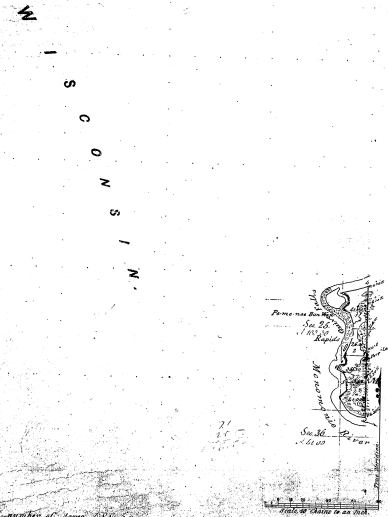

Meanders of								
Posts	Courses	Ch. & Lk.	Posts	Courses	Ch. & Lk.	Posts	Courses	Ch. & Lk.
Total Meanders								

Surveys Designated	By Whom Surveyed	Date of Contract	Date of Surveys	Whom Surveyed	When Charged to the Surv. Genl's acct.
Township lines.	John Mullett	Nov. 28 1867	[illegible]	[illegible]	
Subdivision	[illegible]	[illegible]	[illegible]	[illegible]	

Total number of Acres 1885.60

The above Map of Township No. 38 N. Nat. of Range No. 29 West of the Principal Meridian, Mich., is a plat of the original Meanders of the survey thereof on file in this Office which have been examined and approved.

[illegible] Genl's Office [illegible]