15-40

Re-survey

Township No. 21 N Range No. 8 W Mer. Mich.

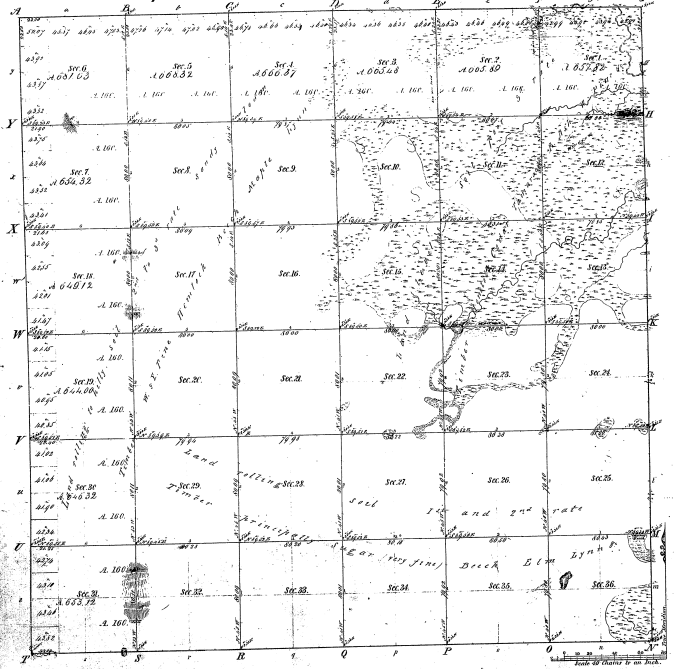

Meanders of					
Posts Courses	Ch.s Lk.s	Posts Courses	Ch.s Lk.s	Posts Courses	Ch.s Lk.s

Total number of Acres. 23,251.79

Survey Designated	By Whom Surveyed	Date of Contract	Amount of Surveys	When Surveyed	When pd. for and ch.d on the Surv.r Gen.ls acc.t
Township Lines	John Brink	Nov.r 14th 1836	15 Chs. 75 Lks. 72 Ch. 08 Lks. 79	4th Quar. 1847	
Subdivisions	W. L. Cuffinberry	April 27th 1852	60 Chs. 75	3rd Quar. 1854	

The above Map of Township No. 21 N of Range No. 8 W of the Principal Meridian of Michigan is strictly conformable to the field notes of the Survey thereof on file in this Office, which have been examined and approved.

Lucius Chapman